

MAR 01 1999

11548

LAND CORNER RECORDATION CERTIFICATE SECTION  
Filing Requirement of Act 74, Mich P.A. 1970

For corners in  
Roscommon County

Located in: Corner Code #

1. Public Land Survey

T22N	R 4W	H-7
T	R	
T	R	
T	R	

FILE IN LIBER 3 OF LAND CORNER

STATE OF MICHIGAN  
ROSCOMMON COUNTY  
RECORDED

22 DEC 98 12:23 P.M.

ROBERT W. SMITH  
REGISTER OF DEEDS

Register of Deeds Stamp & File Number

I, Larry L. Cavanagh, in a field survey December, 1998, do hereby certify that under requirements of P.A. 74, Michigan P.A. of 1970, the corner points mentioned in line 1 above was in conformance with regulations and rules therefore as required in the current manual of survey instructions of the United States Department of the Interior, Bureau of Land Management or by a decree of a Court of Law, established, re-established, monumented, recovered, found as expressed below:

A. Description of original monument and accessories and/or subsequent restoration

ARTEMAS CURTIS, 1852  
SET QUARTER SECTION POST  
CEDAR 6 N25W 15  
TAMARACK 15 S60E 09

LARRY L. CAVANAGH PS 17614, 1998  
FD 1/2" X 18" STEEL BAR  
14' MAPLE N04°E 8.08'  
6' MAPLE N60°W 8.98'

LARRY L. CAVANAGH RLS 17614, 1974  
LCRC LIBER 1 PAGE 97  
SET 1/2" X 18" STEEL BAR  
10' MAPLE N4°E 7.75'  
4' MAPLE N60°W 8.91'

	A	B	C	D	E	F	G	H	I	J	K	L	M
2	6	5	4	3	2	1							
3													
4	7	8	9	10	11	12							
5													
6	18	17	16	15	14	13							
7													
8	19	20	21	22	23	24							
9													
10	30	29	28	27	26	25							
11													
12	31	32	33	34	35	36							
13													

B. Description of corner evidence found and/or method applied in restoring or reestablishing corner:


FOUND 1/2" X 18" STEEL BAR  
14' MAPLE N04°E 8.08'  
6' MAPLE N60°W 8.98'  
THE BEST AVAILABLE EVIDENCE OF THE POSITION OF THE ORIGINAL CORNER.

C. Description of monument for corner and accessories established to perpetuate locating the position of the corner:

SET STANDARD ROSCOMMON COUNTY MONUMENT STAMPED 17614 1998  
WIT: NAIL & TAG IN 14' MAPLE N04°E 8.08' (OLD)  
NAIL & TAG IN 6' MAPLE N60°W 8.98' (OLD)  
NAIL & TAG IN 5' MAPLE S35°W 23.51'  
NAIL & TAG IN 7' MAPLE S85°E 20.68'  
CARSONITE POST NORTH 0.85'

ROSCOMMON COUNTY  
PEER GROUP APPROVAL  
DATE Dec 4, 1998

*Marvin E. Myers*  
Marvin E. Myers, P.S.  
County Surveyor

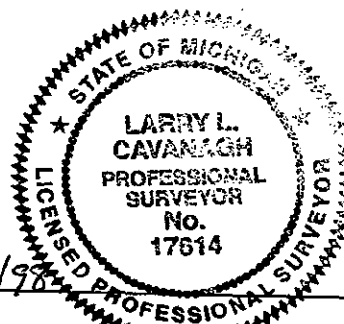

Signed by *Larry L. Cavanagh*  
Surveyor's Michigan License NO. 17614

Date 12/22/98

FORM APPROVED BY MICHIGAN STATE BOARD OF SURVEYORS, JAN 28, 1971  
REVISED MAY 14, 1975  
REVISED JAN., 1983

LIBER 3 PAGE 551