

# SURVEY & REMONUMENTATION

APR 24 1995

**ROSCOMMON COUNTY  
PEER GROUP APPROVAL COMMISSION**

**ROSCOMMON COUNTY REMONUMENTATION  
LAND CORNER RECORDATION CERTIFICATE**  
Filing Requirement of Act 74, Mich. P.A. 1970

STATE OF MICHIGAN  
ROSCOMMON COUNTY  
RECORDED

9203

**DATE** Dec 6, 1994

For corners in

Roscommon <small>(County)</small>	Located In:	Corner Code #
1. Public Land Survey	T <u>22N</u> R <u>4W</u>	<u>I - 4</u>
	T _____ R _____	_____
	T _____ R _____	_____
	T _____ R _____	_____
2. Property Controlling in Section	S _____ T _____ R _____	_____
	S _____ T _____ R _____	_____
3. Miscellaneous Property in Sec.	S _____ T _____ R _____	_____
	S _____ T _____ R _____	_____
4. Lot No. _____, Recorded Plat _____		
5. Private Claims _____		

16 DEC 94 2:38 P.M.

ROBERT W. SMITH  
REGISTER OF DEEDS

TO BE FILED IN LIBER 3 OF LAND CORNER  
Register of Deeds Stamp & File Number

I, Marvin E. Myers, in a field survey on November 11, 1994, do hereby certify that under requirements of P.A. 74, Michigan P.A. of 1970, the corner points mentioned in lines 1 and 2 above were in conformance with regulations and rules therefore as required in the current manual of survey instructions of the United States Department of the Interior, Bureau of Land Management or by a decree of a Court of Law and/or that the corner points mentioned in lines 3, 4 and 5 above were in conformance with the rules of the Michigan Board of Land Surveyors or by a Decree of a Court of Law; established, re-established, monumented, re-monumented, recovered, found as expressed below:

	A	B	C	D	E	F	G	H	I	J	K	L	M
2	6	5	4	3	2	1							
3													
4	7	8	9	10	11	12							
5													
6	18	17	16	15	14	13							
7													
8	19	20	21	22	23	24							
9													
10	30	29	28	27	26	25							
11													
12	31	32	33	34	35	36							

**NOTE: Not more than 4 corners, all in the same town and range, may be recorded on this certificate.**

**A. Description of original monument and accessories and/or subsequent restoration:**


GLO-Artemas Curtis Sept. 1852. Mon-Post WIT: 7" Hemlock N50°E 29 lks. 6" Hemlock S60°W 18 lks.	Cavanagh Aug. 1983 L.434, pg. 126 Mon- WIT: P.Pole West 27.00' 30" Maple S30°E 41.40' 10" Spruce N40°W 58.00' ½" Bar East 33.00'	Cavanagh Feb. 1990 Act 74 Mon-Fd. Iron in Pav't Box WIT: 10" Spruce N40°W 58.00' P.Pole West 27.00' 30" Maple S30°E 41.40'
Cavanagh Sept. 1971 L.259, pg.322 Mon-Fd. 3/4" Bar in Loxley Rd. WIT: P.Pole West 27.00'	Cavanagh April 1987 L.434, pg. 126 Mon- WIT: ½" Bar East 33.00' 10" Spruce N40°W 58.00' P.Pole West 27.00' 30" Maple S30°E 41.40'	Cavanagh Mar. 1994 Mon- WIT: ½" Bar East 33.00' 10" Spruce N40°W 58.00' P.Pole West 27.00' 30" Maple S30°E 41.40'
Cavanagh July 1975 Mon-Fd. 1" Iron WIT: None	Cavanagh 10-16-89 L.1, pg. 270 LCRC Mon-Fd. Iron in Pav't Box WIT: ½" Bar East 33.00' 10" Spruce N40°W 58.00' 30" Maple S30°E 41.40'	L.2, pg. 261 & 262 Mon-5/8" Iron in Road WIT: None
Cavanagh Nov. 1976 L.326, pg.261 Mon- WIT: P.Pole West 27.00' 30" Maple S30°E 41.40'		

**B. Description of corner evidence found and/or method applied in restoring or reestablishing corner:**

Monument - Found 1" x 6" Carriage Bolt in Monument box centerline Loxley Road and 12' South of centerline Perry Road  
 WIT: Found Conc. Mon. S84°E 33.44'  
 Found 12" Spruce N36°W 57.95'  
 Found Utility Pole N87°W 26.53'  
 Found 33" Maple S39½°E 41.26'  
 Accepted as the best available evidence of the position of the original corner.

**C. Description of monument for corner and accessories established to perpetuate locating the position of the corner:**

Mon-Set Std. Roscommon County Monument stamped "T22N R4W I-4 31600" in Mon. Box  
 WIT: Set nail E. 12" Spruce N36°W 58.33'  
 Set nail S. side Power Pole N87°W 27.18'  
 Set nail SE 33" Maple S39½°E 42.62'  
 Fd. Conc. Mon. S84°E 33.44'  
 Set Carsonite Post S84°E 33.75'  
 Fd. ½" Bar & Cap #17614 N40°W 47.63'

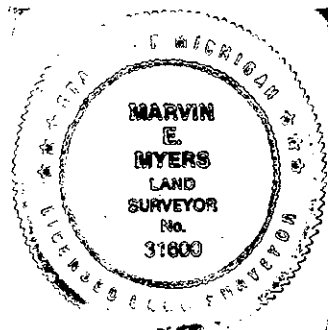

Signed by Marvin E. Myers Date Dec 15, 1994

Surveyor's Michigan License No. 31600