

SURVEY & REMONUMENTATION

ROSCOMMON COUNTY APR 24 1995

PEER GROUP APPROVAL COMMISSION

DATE Dec 6, 1994 **ROSCOMMON COUNTY REMONUMENTATION
LAND CORNER RECORDATION CERTIFICATE**
Filing Requirement of Act 74, Mich. P.A. 1970

STATE OF MICHIGAN
ROSCOMMON COUNTY
RECORDED

16 DEC 94 2:36 P.M.

ROBERT W. SMITH
REGISTER OF DEEDS

TO BE FILED IN LIBER 3 OF LAND CORNERS
Register of Deeds Stamp & File Number

For corners in

Roscommon (County)	Located In:	Corner Code #:	
1. Public Land Survey	T <u>22N</u> , R <u>4W</u>	I - 5	
	T _____ R _____	_____	_____
	T _____ R _____	_____	_____
	T _____ R _____	_____	_____
2. Property Controlling in Section	S _____ T _____ R _____	_____	_____
	S _____ T _____ R _____	_____	_____
3. Miscellaneous Property in Sec.	S _____ T _____ R _____	_____	_____
	S _____ T _____ R _____	_____	_____
4. Lot No. _____, Recorded Plat _____			
5. Private Claims _____			

	A	B	C	D	E	F	G	H	I	J	K	L	M
2	6	5	4	3	2	1							
3													
4	7	8	9	10	11	12							
5					●								
6	18	17	16	15	14	13							
7													
8	19	20	21	22	23	24							
9													
10	30	29	28	27	26	25							
11													
12	31	32	33	34	35	36							
13													

I, Marvin E. Myers, in a field survey on November 22, 1994, do hereby certify that under requirements of P.A. 74, Michigan P.A. of 1970, the corner points mentioned in lines 1 and 2 above were in conformance with regulations and rules therefore as required in the current manual of survey instructions of the United States Department of the Interior, Bureau of Land Management or by a decree of a Court of Law and/or that the corner points mentioned in lines 3, 4 and 5 above were in conformance with the rules of the Michigan Board of Land Surveyors or by a Decree of a Court of Law; established, re-established, monumented, re-monumented, recovered, found as expressed below:

NOTE: Not more than 4 corners, all in the same town and range, may be recorded on this certificate.

A. Description of original monument and accessories and/or subsequent restoration:


GLO-Artemas Curtis 1852 Mon-Post WIT: 7" Spruce N70°E 19 lks. 6" Spruce S60°W 46 lks.	Cavanagh July 1975 Mon-Fd. Pav't Box WIT: None Cavanagh April 1987 Mon-None WIT: U.P. S15°E 83.11' U.P. N20°W 110.35' U.P. N19°W 75.34' Sign Post S30°W 63.86'	Cavanagh 4-17-89 L.1, pg. 271 LCRC Mon-Iron in Pav't Box WIT: U.P. S15°E 83.11' U.P. S20°W 110.35' U.P. N19°W 75.34' Sign Post S30°W 63.86'
Henning & Ostling July 1945 Mon-Set 5/8"x18" Iron rod <u>L</u> roads WIT: None	Cavanagh Mar. 1994 Mon- WIT: U.P. S15°E 83.11' U.P. S20°W 110.35' U.P. N19°W 75.34' Sign Post S30°W 63.86'	
Henning 8-9-73 L.278, pg.633 Mon-Pav't Box at Sec. Cor.		
Cavanagh June 1972 Mon-Fd. Iron in Pav't Box		

B. Description of corner evidence found and/or method applied in restoring or reestablishing corner:

Monument - Found 5/8" x 24" Iron in Pavement Box in centerline County Road 305 and 2' East of centerline Loxley Road
WIT: Found nail East side Utility Pole S14°E 83.10'
Found MDOT nail & tag SW side Utility Pole N20°W 75.30'
Found nail East side Utility Pole S19°W 110.45'
Accepted as the best available evidence of the position of the original corner.

C. Description of monument for corner and accessories established to perpetuate locating the position of the corner:

Mon-Set Std. Roscommon County Monument stamped "T22N R4W I-5 36L00) in mon. box
WIT: Fd. MSHD nail & tag SW P.Pole N20°W 75.30'
Fd. nail E. side P.Pole S14°E 83.10'
Fd. nail E. side P.Pole S19°W 110.45'
Set nail W. face fence post N41°E 58.35'
E. edge Stop Sign Post S32°W 49.22'

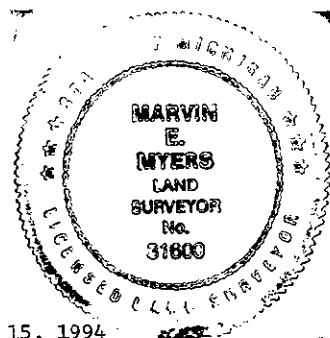

Signed by Marvin E. Myers

Dec 15, 1994

Surveyor's Michigan License No. 31600