

SURVEY & REMONUMENTATION

APR 24 1995

**ROSCOMMON COUNTY
COMMISSION**

PEER GROUP APPROVAL

DATE Dec 6, 1994

**ROSCOMMON COUNTY REMONUMENTATION
LAND CORNER RECORDATION CERTIFICATE
Filing Requirement of Act 74, Mich. P.A. 1970**

STATE OF MICHIGAN
ROSCOMMON COUNTY
RECORDED

For corners in

Roscommon <small>(County)</small>	Located In:	Corner Code #	
1. Public Land Survey	T <u>22N</u> R <u>4W</u>	<u>I - 6</u>	
	T _____ R _____	_____	
	T _____ R _____	_____	
	T _____ R _____	_____	
2. Property Controlling in Section	S _____ T _____ R _____	_____	
	S _____ T _____ R _____	_____	
3. Miscellaneous Property in Sec.	S _____ T _____ R _____	_____	
	S _____ T _____ R _____	_____	
4. Lot No. _____, Recorded Plat _____			
5. Private Claims _____			

16 DEC 94 2:36 P.M.

ROBERT W. SMITH
REGISTER OF DEEDS

TO BE FILED IN LIBER 3 OF LAND CORNER
Register of Deeds Stamp & File Number

	A	B	C	D	E	F	G	H	I	J	K	L	M
2	6	5	4	3	2	1							
3													
4	7	8	9	10	11	12							
5													
6	18	17	16	15	14	13							
7													
8	19	20	21	22	23	24							
9													
10	30	29	28	27	26	25							
11													
12	31	32	33	34	35	36							
13													

I, Marvin E. Myers, in a field survey on November 28, 1994, do hereby certify that under requirements of P.A. 74, Michigan P.A. of 1970, the corner points mentioned in lines 1 and 2 above were in conformance with regulations and rules therefore as required in the current manual of survey instructions of the United States Department of the Interior, Bureau of Land Management or by a decree of a Court of Law and/or that the corner points mentioned in lines 3, 4 and 5 above were in conformance with the rules of the Michigan Board of Land Surveyors or by a Decree of a Court of Law; established, re-established, monumented, re-monumented, recovered, found as expressed below:

NOTE: Not more than 4 corners, all in the same town and range, may be recorded on this certificate.

A. Description of original monument and accessories and/or subsequent restoration:


GLO-Artemas Curtis Sept. 1852 Mon-Post WIT: 8" Spruce N48°W 24 lks. 16" hemlock S67°E 20 lks.	Cavanagh 8-6-75 Mon-1" Bar WIT: None L.2, pg.265 LCRC Mon-1"x14" Iron in pav't WIT: B.T. Cedar Post S75½°E 55.00' B.T. 8" Aspen S84½°W 55.00'	Cavanagh May 1980 Mon- WIT: Cedar Post S75½°E 55.00' 8" Aspen S84½°W 55.00' P.K. Nail S00°32'W 442.29' P.K. Nail N00°32'E 634.25'
George D. Henning May 1947 Mon-Iron in pav't WIT: B.T. Cedar Post S75½°E 55.00' B.T. 8" Aspen S84½°W 55.00'	Cavanagh Aug. 1979 L.1, pg.212 LCRC Mon-1" Iron WIT: Cedar Post S75½°E 55.00' 8" Aspen S84½°W 55.00' P.K. Nail S00°32'W 442.29' P.K. Nail N00°32'E 634.25'	Cavanagh Oct. 1982 Mon- WIT: Cedar Post S75½°E 55.00' 8" Aspen S84½°W 55.00'
Cavanagh 6-8-72 Mon-1" Bar WIT: None		

B. Description of corner evidence found and/or method applied in restoring or reestablishing corner:

Monument - Found 1" x 9" Iron Bar in pavement box 0.5' East of centerline Loxley Road
 WIT: Found Poplar Stump S86°W 54.80'
 Found 4" Cedar fence post S75°E 55.00'
 Accepted as the best available evidence of the position of the original corner.

C. Description of monument for corner and accessories established to perpetuate locating the position of the corner:

Mon-Set Std. Roscommon County Monument stamped "T22N R4W I-6 31600" in Mon. Box
 WIT: Fd. Poplar stump S86°W 54.80'
 Set nail N. side cor. fence post East 54.30'
 W. edge "Slow Children Playing" sign N43°E 37.24'
 Set nail S. side 3" Poplar N74°W 45.76'
 Set nail S. side 14" Poplar S46°W 67.97'
 Fd. 4" Cedar fence post S75°E 55.00'

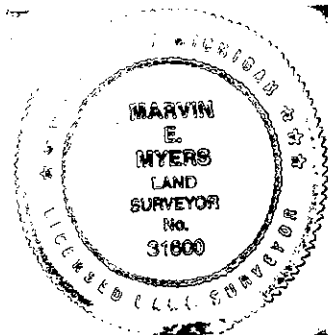

Signed by Marvin E. Myers Date Dec 15, 1994
 Surveyor's Michigan License No. 31600