

MAR 01 1999

11506

LAND CORNER RECORDATION CERTIFICATE  
Filing Requirement of Act 74, Mich. P.A. 1970

For corners in

Roscommon  
(County)

Located In:

Corner Code #

1. Public Land Survey

T 22NR 4W

1-9

2. Property Controlling  
in Section

S

3. Miscellaneous  
Property in Sec.

S

S

S

T R  
T R  
T R  
T R  
T R  
T R  
T R

\_\_\_\_\_  
\_\_\_\_\_  
\_\_\_\_\_  
\_\_\_\_\_  
\_\_\_\_\_  
\_\_\_\_\_  
\_\_\_\_\_

4. Lot No. \_\_\_\_\_, Recorded Plat \_\_\_\_\_  
5. Private Claims \_\_\_\_\_

SECTION  
FILE IN LIBER 3 OF LAND CORNERS

STATE OF MICHIGAN  
ROSCOMMON COUNTY  
RECORDED

22 DEC 98. 9:07 A.M.

ROBERT W. SMITH  
REGISTER OF DEEDS

Register of Deeds Stamp & File  
Number

I, Marvin E. Myers, in a field survey on Dec 1, 1998 do hereby state that under requirements of P.A. 74, Michigan P.A. of 1970, the corner points mentioned in lines 1 and 2 above were in conformance with regulations and rules therefore as required in the current manual of survey instructions of the United States Department of the Interior, Bureau of Land Management or by a decree of a Court of Law and /or that the corner points mentioned in lines 3, 4 and 5 above were in conformance with the rules of the Michigan Board of Land Surveyors or by a Decree of a Court of Law, established, re-established, monumented, recovered, found as expressed below:

A	B	C	D	E	F	G	H	I	J	K	L	M
1												
2	6		5		4		3		2		1	
3												
4	7		8		9		10		11		12	
5												
6	18		17		16		15		14		13	
7												
8	19		20		21		22		23		24	
9												
10	30		29		28		27		26		25	
11												
12	31		32		33		34		35		36	
13												

NOTE: Not more than 2 corners, all in the same town and range, may be recorded on this certificate.

A. Description of original monument and accessories and/or subsequent restoration:

GLO - July 1852 John Brink, D.S.  
Mon - Post  
Wit: 12" B. Oak N50°E 8 Lks  
14" W. Pine S75°W 20 Lks.

L1, P83-84 L. Cavanagh, P.S. 17614  
April 1973  
Mon - Found 1/2" bar  
5" W. Pine S43°W 53.2  
P.Pole S30°E 34.22  
P. Pole N45°E 57.27

L 316, P 609 May 1976 L. L. Cavanagh, PS #17614  
Mon - 1/2" Bar  
Wit: 5" W. Pine S43°W 53.2  
P.Pole S30°E 34.22  
P.Pole N45°E 57.27


Aug 1948 R.T. Ostling, #5520  
Mon - Found Sq. 20" Shaft & Casting  
Wit: Mk'd BT 8" Aspen N61°E 87.3  
Spike in 7" W. Pine S48°E 108.7  
Spike in P.Pole N57 1/2°W 107.4

L2, P. 273-274 LCRC  
Mon - 1/2" Bar  
5" W. Pine S43°W 53.2  
P.Pole S30°E 34.22  
P.Pole N45°E 57.27

L 329, P 289 Nov 1976 L. L. Cavanagh PS #17614  
Mon - 1/2" Bar  
Wit: 5" W. Pine S43°W 53.2  
P.Pole S30°E 34.22  
P.Pole N45°E 57.27

B. Description of corner evidence found and/or method applied in restoring or reestablishing corner:  
Found Pk nail over 1/2"x18" bar in asphalt 2.7± South of E-W Emery Road in center of Loxley Road North; found spike in P.Pole N57 1/2°W 107.4; found spike in 6" W. Pine S55°W 61.35. Accepted as the best available evidence of the position of the original Government Corner. Replaced with Standard Roscommon County monument in pav't monument box.

C. Description of monument for corner and accessories established to perpetuate locating the position of the corner:  
Mon - Set Standard Roscommon County Monument in Pav't Monument Box.  
Wit: Found Spike in 6" W. Pine S55°W 61.35  
Found Spike in P. Pole N57 1/2°W 107.40  
PK nail & tag P. Pole S48°E 34.73  
PK nail & tag P. Pole N65°W 74.80  
Set carsonite Post S36°W 35.0

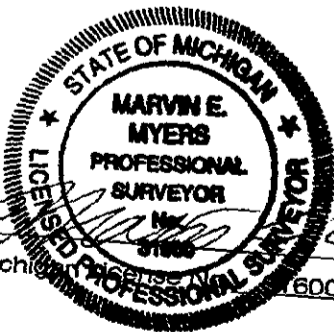

ROSCOMMON COUNTY  
PEER GROUP APPROVAL

DATE Dec 4, 1998

Marvin E. Myers  
Marvin E. Myers, P.S.  
County Surveyor

Signed by

Surveyor's Michigan Professional

Date December 17, 1998

LIBER 3 PAGE 542