

SURVEY & REMONUMENTATION

APR 24 1995

ROSCOMMON COUNTY COMMISSION

PEER GROUP APPROVAL

DATE Dec 6, 1994 *MEM*

ROSCOMMON COUNTY REMONUMENTATION
LAND CORNER RECORDATION CERTIFICATE
Filing Requirement of Act 74, Mich. P.A. 1970

STATE OF MICHIGAN
ROSCOMMON COUNTY
RECORDED

16 DEC 94 2:38 P.M.

ROBERT W. SMITH
REGISTER OF DEEDS

TO BE FILED IN LIBER 3 OF LAND CORNERS
Register of Deeds Stamp & File Number

For corners in

Roscommon (County)	Located In:	Corner Code #	
1. Public Land Survey	T <u>22N</u> R <u>4W</u>	<u>J - 6</u>	
	T _____ R _____	_____	
	T _____ R _____	_____	
	T _____ R _____	_____	
2. Property Controlling in Section	S _____ T _____ R _____	_____	
	S _____ T _____ R _____	_____	
3. Miscellaneous Property in Sec.	S _____ T _____ R _____	_____	
	S _____ T _____ R _____	_____	
4. Lot No. _____, Recorded Plat _____			
5. Private Claims _____			

	A	B	C	D	E	F	G	H	I	J	K	L	M
2	6	5	4	3	2	1							
3													
4	7	8	9	10	11	12							
5													
6	18	17	16	15	14	13							
7													
8	19	20	21	22	23	24							
9													
10	30	29	28	27	26	25							
11													
12	31	32	33	34	35	36							
13													

I, Marvin E. Myers, in a field survey on December 2, 1994, do hereby certify that under requirements of P.A. 74, Michigan P.A. of 1970, the corner points mentioned in lines 1 and 2 above were in conformance with regulations and rules therefore as required in the current manual of survey instructions of the United States Department of the Interior, Bureau of Land Management or by a decree of a Court of Law and/or that the corner points mentioned in lines 3, 4 and 5 above were in conformance with the rules of the Michigan Board of Land Surveyors or by a Decree of a Court of Law; established, re-established, monumented, re-monumented, recovered, found as expressed below:

NOTE: Not more than 4 corners, all in the same town and range, may be recorded on this certificate.

A. Description of original monument and accessories and/or subsequent restoration:

George D. Henning May 1947
Mon-2"x48" Well Point
WIT: B.T. 5" B.Oak S48°E 44.80'
B.T. 5" B.Oak S43½°W 35.30'
B.T. 5" B.Oak N25°W 31.70'


L.2, pg.265
Mon-2"x48" Well Point
WIT: 5" B.Oak S48°E 44.80'
5" B.Oak S43½°W 35.30'
5" B.Oak N25°W 31.70'

B. Description of corner evidence found and/or method applied in restoring or reestablishing corner:

Monument - Found 4" x 36" Conc. Mon. over 2" well point in centerline intersection Crestline and road to North
WIT: I-6 N83°37'23"W 2651.74'
K-6 S83°37'45"E 2608.83'
J-5 N05°32'41"E 2682.82'
J-7 S05°33'04"W 2640.13'
Accepted as the best available evidence of the position of the original corner.

C. Description of monument for corner and accessories established to perpetuate locating the position of the corner:

Mon-Set Std. Roscommon County Mon. stamped "T22N R4W J-6 31600" in Mon. Box over 2" well point
WIT: Set Wit. Tag & Nail NW side 6" R.Pine N70°E 53.56'
Set Wit. Tag & Nail NE side U.P. S41°E 43.02'
Set Wit. Tag & Nail NW side 12" B.Oak S24°W 59.55'
Set Wit. Tag & Nail NE side 6" R.Oak N29°W 98.70'
I-6 N83°37'23"W 2651.74'
K-6 S83°37'45"E 2608.83'
J-5 N05°32'41"E 2682.82'
J-7 S05°33'04"W 2640.13'

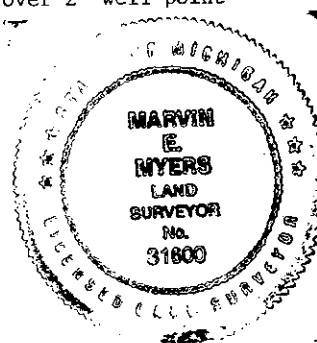

Signed by

Marvin E. Myers

Date

Dec 15, 1994

Surveyor's Michigan License No.

31600