

SURVEY & REMONUMENTATION

APR 24 1995

ROSCOMMON COUNTY
PEER GROUP APPROVAL
DATE Dec 6, 1994

9201

COMMISSION ROSCOMMON COUNTY REMONUMENTATION LAND CORNER RECORDATION CERTIFICATE Filing Requirement of Act 74, Mich. P.A. 1970

STATE OF MICHIGAN
ROSCOMMON COUNTY
RECORDED

For corners in

Roscommon	Located In:	Corner Code #	
(County)			
1. Public Land Survey	T <u>22N</u> R <u>4W</u>	<u>K - 7</u>	
	T _____ R _____	_____	
	T _____ R _____	_____	
	T _____ R _____	_____	
2. Property Controlling	S _____ T _____ R _____	_____	
in Section	S _____ T _____ R _____	_____	
3. Miscellaneous	S _____ T _____ R _____	_____	
Property in Sec.	S _____ T _____ R _____	_____	

16 DEC 94 2:38 P.M.

ROBERT W. SMITH
REGISTER OF DEEDS

TO BE FILED IN LIBER 3 OF LAND CORNER
Register of Deeds Stamp & File Number

4. Lot No. _____, Recorded Plat _____
5. Private Claims _____

I, Marvin E. Myers, in a field survey on November 23, 1994, do hereby certify that under requirements of P.A. 74, Michigan P.A. of 1970, the corner points mentioned in lines 1 and 2 above were in conformance with regulations and rules therefore as required in the current manual of survey instructions of the United States Department of the Interior, Bureau of Land Management or by a decree of a Court of Law and/or that the corner points mentioned in lines 3, 4 and 5 above were in conformance with the rules of the Michigan Board of Land Surveyors or by a Decree of a Court of Law; established, re-established, monumented, re-monumented, recovered, found as expressed below:

	A	B	C	D	E	F	G	H	I	J	K	L	M
2	6	5	4	3	2	1							
3													
6	7	8	9	10	11	12							
8	18	17	16	15	14	13							
7													
8	19	20	21	22	23	24							
9													
10	30	29	28	27	26	25							
11													
12	31	32	33	34	35	36							
13													

NOTE: Not more than 4 corners, all in the same town and range, may be recorded on this certificate.

A. Description of original monument and accessories and/or subsequent restoration:


<p>GLO-Artemas Curtis Mon-Set Post WIT: 18" Y.Pine N40°W 74 lks. 12" Y.Pine S70°E 24 lks.</p>	<p>Ostling July 1963 Mon-1" Axel Shaft WIT: Spike 10" B.Oak N45°W 65.30' Spike 22" B.Oak S39½°E 36.00' Spike T.P. S33½°W 56.90'</p>	<p>Cavanagh Feb. 1973 L.1, pg.78 LCRC Mon-Iron in Pav't Box WIT: 24" B.Oak S40°E 36.70' 18" B.Oak N40°W 65.00' P.Pole N45°E 38.50'</p>
<p>G.Henning July 1943 Mon-1" Axel Shaft WIT: Spike 10" B.Oak N45°W 65.30' Spike 22" B.Oak S39½°E 36.00' Spike T.P. S33½°W 56.90'</p>	<p>Date & Surveyor Unknown Mon-Pav't Box WIT: 18" B.Oak N40°W 65.00' P.Pole N45°W 38.50'</p>	<p>Cavanagh June 1978 L.348, pg.587 Mon-Iron in Pav't Box WIT: 24" B.Oak S40°E 36.90' 18" B.Oak N40°W 65.00' P.Pole N45°E 38.50'</p>
<p>G.Henning May 1947 Mon-1" Axel Shaft in Rd. int. WIT: Spike 10" B.Oak N45°W 65.30' Spike 22" B.Oak S39½°E 36.00' Spike T.P. S33½°W 56.90'</p>	<p>L.2, pg.264 LCRC Mon-Mon. Box in Tower Hill Rd. WIT: None</p>	<p>Cavanagh Aug. 1979 L.1, pg.212 LCRC Mon-1" Axel Shaft WIT: 10" Oak S39½°E 36.00' 22" Oak S39½°E 36.00' T.Pole S33½°W 56.90' ½" Bar N79°32'E 203.49'</p>
		<p>Cavanagh July 1986 Mon-Iron in Pav't Box WIT: 24" B.Oak S40°E 36.90' 18" B.Oak N40°W 65.00' P.Pole N45°E 38.50'</p>

B. Description of corner evidence found and/or method applied in restoring or reestablishing corner:

Monument - Found 3/4" x 24" Bar in Mon. Box 1.6' East of centerline Tower Hill Road and centerline Nestle Road over 1½" Axel Shaft
WIT: Fd. nail NW side 28" B.Oak S51°W 59.29'
Fd. nail SW side 35" B.Oak S39°E 85.43'
Fd. nail SW side Tw. B.Oak N40°W 65.67'
Accepted as the best available evidence of the position of the original corner.

C. Description of monument for corner and accessories established to perpetuate locating the position of the corner:

Mon-Set Std. Roscommon County Mon. stamped "T22N R4W K-7 31600" in Mon. Box
WIT: Fd. nail NW side 28" B.Oak S51°W 59.29'
Fd. nail SW side 35" B.Oak S39°E 85.43'
Fd. nail SW side 20" Tw. B.Oak N40°W 65.67'
Set nail SE side U.P. N54°E 45.29'

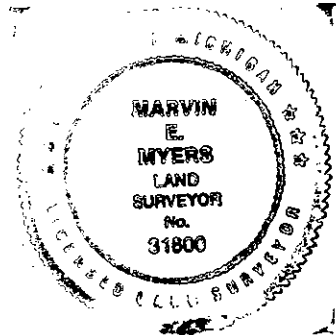

Signed by Marvin E. Myers Date Dec 15, 1994
Surveyor's Michigan License No. 31600

LIBER 3 PAGE 101