

MAR 01 1999

11511

LAND CORNER RECORDATION CERTIFICATE
Filing Requirement of Act 74, Mich. P.A. 1970

SECTION


For corners in

Table with columns: Roscommon (County), Located In: (T 22NR 4W), Corner Code # (K-9). Rows include Public Land Survey, Property Controlling in Section, and Miscellaneous Property in Sec.

FILE IN LIBER 3 OF LAND CORNERS
STATE OF MICHIGAN
ROSCOMMON COUNTY
RECORDED
22 DEC 98 9:08 A.M.
ROBERT W. SMITH
REGISTER OF DEEDS
Register of Deeds Stamp & File Number

4. Lot No. , Recorded Plat
5. Private Claims

I, Marvin E. Myers, in a field survey on Dec 1 19 98 do hereby state that under requirements of P.A. 74, Michigan P.A. of 1970, the corner points mentioned in lines 1 and 2 above were in conformance with regulations and rules therefore as required in the current manual of survey instructions of the United States Department of the Interior, Bureau of Land Management or by a decree of a Court of Law and /or that the corner points mentioned in lines 3, 4 and 5 above were in conformance with the rules of the Michigan Board of Land Surveyors or by a Decree of a Court of Law; established, re-established, monumented, recovered, found as expressed below:

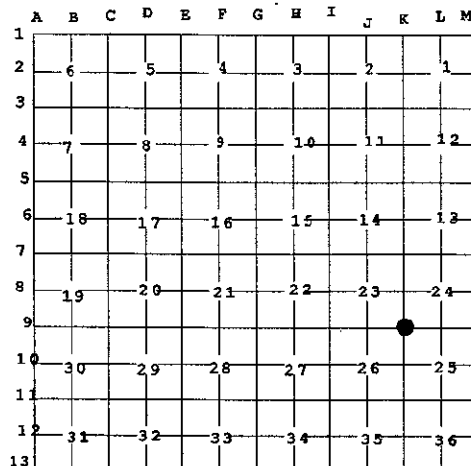

NOTE: Not more than 2 corners, all in the same town and range, may be recorded on this certificate.

A. Description of original monument and accessories and/or subsequent restoration:

- List of survey records including: GLO - July 1852 John Brink, D.S. Mon - Post; L. 311, P. 545 Nov 18, 1975 Frank J. Arieth, P.S. # 21266; L. 337, P. 35 Nov 1976 #21266; LORC L. 1, P. 192 April 1979 Larry L. Cavanagh, P.S. #17614; Aug 1948 R.T. Ostling #5520; L. 326, P. 266 Sept 1976; L. 400, P. 292 Mar 1979 George D. Henning, P.S. #2240; LORC L. 1, P. 77-78; L. 481, P. 374 Dec 6, 1985 P.S. #17614; Feb 1973 L. Cavanagh, P.S. #17614; L. 326, P. 266 Sept 1976; L. 400, P. 292 Mar 1979.

B. Description of corner evidence found and/or method applied in restoring or reestablishing corner: Found 1" iron bar in Water valve box in centerline of E-W road 3 East of N-S road centerline; found P. Pole S45°W 43.3; Accepted 1" Iron bar as the best available evidence of the position of the Original Corner. Replaced 1" bar with Standard Roscommon County Monument in pav't monument box.


C. Description of monument for corner and accessories established to perpetuate locating the position of the corner: Mon - Standard Roscommon County Monument in pavement monument box.

- Wit: Set PK nail & tag 18" Oak N40°W 148.35; PK nail & tag in P. Pole S48°W 43.05; PK nail & tag in Guy Pole N41°E 42.93; Set PK nail & tag 10" Oak S46°E 97.08; Set carsonite post S44°E 65.5

ROSCOMMON COUNTY
PEER GROUP APPROVAL

DATE Dec 9, 1998

Signature of Marvin E. Myers, P.S.
Marvin E. Myers, P.S.
County Surveyor

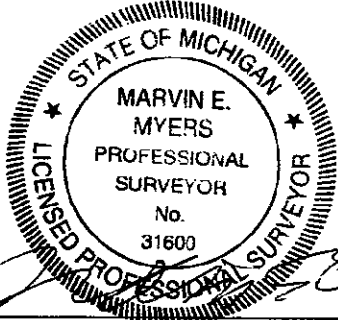

Signed by [Signature]
Surveyor's Michigan License No. 31600

Date December 17, 1998

LIBER 3 PAGE 547