

SURVEY & REMONUMENTATION

APR 24 1995

**ROSCOMMON COUNTY
PEER GROUP APPROVAL**

DATE Dec 6, 1994

COMMISSION
ROSCOMMON COUNTY REMONUMENTATION
LAND CORNER RECORDATION CERTIFICATE
Filing Requirement of Act 74, Mich. P.A. 1970

STATE OF MICHIGAN
ROSCOMMON COUNTY
RECORDED

16 DEC 94 2:39 P.M.

ROBERT W. SMITH
REGISTER OF DEEDS

TO BE FILED IN LIBER 3 OF LAND CORNER
Register of Deeds Stamp & File Number

For corners in

Roscommon <small>County</small>	Located In:	Corner Code #
1. Public Land Survey	T 22N R 4W	L - 7
	T R	
	T R	
	T R	
2. Property Controlling in Section	S T R	
	S T R	
3. Miscellaneous Property in Sec.	S T R	
	S T R	

4. Lot No. _____, Recorded Plat _____
5. Private Claims _____

	A	B	C	D	E	F	G	H	I	J	K	L	M
2	6	5	4	3	2	1							
3													
4	7	8	9	10	11	12							
5													
6	18	17	16	15	14	13							
7													
8	19	20	21	22	23	24							
9													
10	30	29	28	27	26	25							
11													
12	31	32	33	34	35	36							
13													

I, Marvin E. Myers, in a field survey on November 23, 19 94, do hereby certify that under requirements of P.A. 74, Michigan P.A. of 1970, the corner points mentioned in lines 1 and 2 above were in conformance with regulations and rules therefore as required in the current manual of survey instructions of the United States Department of the Interior, Bureau of Land Management or by a decree of a Court of Law and/or that the corner points mentioned in lines 3, 4 and 5 above were in conformance with the rules of the Michigan Board of Land Surveyors or by a Decree of a Court of Law; established, re-established, monumented, re-monumented, recovered, found as expressed below:

NOTE: Not more than 4 corners, all in the same town and range, may be recorded on this certificate.

A. Description of original monument and accessories and/or subsequent restoration:


GLO-Artemas Curtis Sept. 1852 Mon-Post WIT: 6" W.Oak N30°W 13 lks. 8" Birch S80°E 17 lks.	L. Cavanagh Feb. 1973 L.1, pg.78 LCRC Mon-½" Bar WIT: 8" W.Oak S43°W 27.40' 8" R.Oak N26°W 38.40' 12" W.Oak N74°E 27.00'	Cavanagh July 1986 L.484, pg.250 Mon-Fd. ½" Bar WIT: 6" Maple S10°07'E 11.40' 8" W.Oak N48°10'W 20.60' 9" R.Oak N07°45'E 30.30'
L.2, pg.264 LCRC Mon-½"x30" Bar WIT: 8" W.Oak S43°W 27.40' 8" R.Oak N26°W 38.40' 12" W.Oak N74°E 27.00'	Cavanagh Apr. 1977 L.331, pg.447 Mon-½" Bar WIT: 8" R.Oak N26°W 38.40' 8" W.Oak S43°W 27.40' 12" W.Oak N74°E 27.00'	Cavanagh Aug. 1987 Mon- WIT: 6" Maple S10°07'E 11.40' 8" W.Oak N48°10'W 20.60' 9" R.Oak N07°45'E 30.30'
Ostling Surveys Aug. 1963 Mon- WIT: B.Oak S45°E 26.00' 8" Poplar N84½°E 14.80' 5" W.Oak N50½°W 20.70'	Cavanagh June 1978 L.348, pg.587 Mon- WIT: 6" Maple S10°07'E 11.40' 8" W.Oak N48°10'W 20.64' 9" R.Oak N07°45'E 30.30'	

B. Description of corner evidence found and/or method applied in restoring or reestablishing corner:

Monument - Found ½" x 18" Bar & Cap in centerline of Nestle Road over ½" x 24" bar.
WIT: Fd. ½" bar & cap #17614 N03°E 33.09'
Accepted as the best available evidence of the position of the original corner.

C. Description of monument for corner and accessories established to perpetuate locating the position of the corner:

Mon- Set Std. Roscommon County Mon. stamped "T22N R4W L-7 31600" in Mon. Box in centerline Nestle Road
WIT: Set wit. tag & nail SW side 7" Maple N33°W 49.39'
Set wit. tag & nail NW side 13" W.Pine S65°W 79.75'
Set wit. tag & nail E. side 20" W.Oak S02½°W 71.15'
Fd. ½" bar #17614 N03°E 33.09'
Set Carsonite post S06°W 33.00'

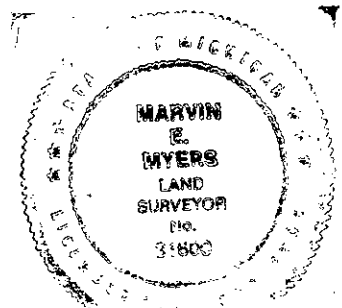

Signed by Marvin E. Myers
Surveyor's Michigan License No. 31600

Date Dec 15, 1994