

LAND CORNER RECORDATION CERTIFICATE

Filing Requirement of Act 74, Mich. PA 1970

For Corners In: ROSCOMMON Located In _____ Corner Code # _____
(County)

1. Public Land Survey T _____ R _____
T _____ R _____

2. Property Controlling in Section S 30 T 22N R 4W 6
S 30 T 22N R 4W 9


3. Miscellaneous Property in Section S _____ T _____ R _____
S _____ T _____ R _____

4. Lot No: _____ Recorded Plat: _____

5. Private Claims: _____

I, Carl T. Kiiskila, in a field survey on NOV. 1, 1998 do hereby state that under requirements of PA 74, Michigan PA of 1970, the corner points mentioned in lines 1 and 2 above were in conformance with regulations and rules therefore as required in the current manual of survey instructions of the United States Department of the Interior, Bureau of Land Management or by a decree of a Court of Law and/or that the corner points mentioned in lines 3, 4 and 5 above were in conformance with the rules of the Michigan Board of Land Surveyors or by a Decree of a Court of Law; established, re-established, monumented, recovered, found as expressed below:

NOTE: Not more than 2 corners, all in the same town and range, may be recorded on this certificate.

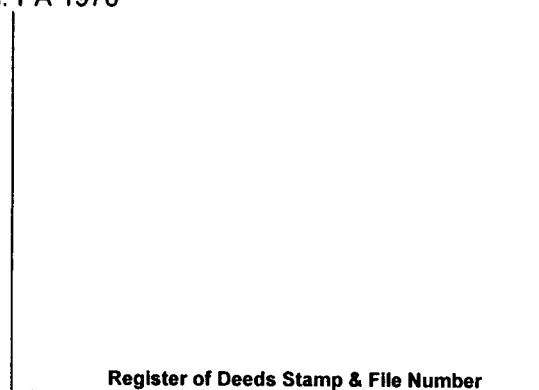

	A	B	C	D	E	F	G	H	I	J	K	L	M
1													
2	6		5		4		3		2		1		
3													
4	7		8		9		10		11		12		
5													
6	18		17		16		15		14		13		
7													
8	19		20		21		22		23		24		
9													
10	30		29		28		27		26		25		
11													
12	31		32		33		34		35		36		
13													

A. Description of original monument and accessories and/or subsequent restoration:
 6 - THIS POSITION WAS NOT ESTABLISHED DURING THE ORIGINAL GOVERNMENT SURVEY. 9 - THIS POSITION WAS NOT ESTABLISHED DURING THE ORIGINAL GOVERNMENT SURVEY.

B. Description of corner evidence found and/or method applies in restoring or re-establishing corner:
 6 - ESTABLISHED THE NORTHEAST CORNER OF THE SOUTHWEST QUARTER OF THE NORTHEAST QUARTER OF SECTION 30 PER STANDARD B.L.M. INSTRUCTIONS FOR THE SUBDIVISION OF A SECTION.
 9 - FOUND AND ACCEPTED A 1/2" ROD AS SET BY GEORGE HENNING, R.L.S. # 2240 FOR THE SOUTHWEST CORNER OF THE SOUTHWEST QUARTER OF THE NORTHEAST QUARTER OF SECTION 30. THIS POSITION FITS STANDARD B.L.M. INSTRUCTIONS FOR THE SUBDIVISION OF A SECTION.

C. Description of monument for corner and accessories established to perpetuate locating the position of the corner:
 6 - SET 5/8"X32" REROD WITH CAP & CARSONITE POST.
 WIT: 4" WHITE PINE S05°W 32.48'
 4" MAPLE N89°W 18.85'
 7" WHITE PINE N04°E 16.42'
 S.W. CORNER OF HOUSE FOUNDATION S88°E 30.60'
 CARSONITE POST WEST 0.5'

9 - SET 1"X32" PIPE WITH P.S.CAP & CARSONITE POST.
 WIT: 14" OAK N20° W 14.83'
 10" OAK S84° W 41.83'
 * 10" OAK S58° W 32.33'
 * 14" OAK S87° E 37.54'
 CARSONITE POST NORTH 0.5'
 CORNER FALLS IN N & S FENCE

Signed by: Carl T Kiiskila
 Surveyor's Michigan License No.: 33981

Date: 6-22-99

