

LAND CORNER RECORDATION CERTIFICATE

Filing Requirement of Act 74, Mich. PA 1970

For Corners In:
ROSCOMMON Located In _____ Corner Code # _____
 (County)

1. Public Land Survey	T _____	R _____		
	T _____	R _____		
2. Property Controlling in Section	S <u>30</u>	T <u>22N</u>	R <u>4W</u>	<u>3</u>
	S <u>30</u>	T <u>22N</u>	R <u>4W</u>	<u>14</u>
3. Miscellaneous Property in Section	S _____	T _____	R _____	
	S _____	T _____	R _____	


4. Lot No: _____ Recorded Plat: _____

5. Private Claims: _____

I, Carl T. Kiiskila, in a field survey on OCT. 08, 1998 do hereby state that under requirements of PA 74, Michigan PA of 1970, the corner points mentioned in lines 1 and 2 above were in conformance with regulations and rules therefore as required in the current manual of survey instructions of the United States Department of the Interior, Bureau of Land Management or by a decree of a Court of Law and/or that the corner points mentioned in lines 3, 4 and 5 above were in conformance with the rules of the Michigan Board of Land Surveyors or by a Decree of a Court of Law; established, re-established, monumented, recovered, found as expressed below:

NOTE: Not more than 2 corners, all in the same town and range, may be recorded on this certificate.

Register of Deeds Stamp & File Number

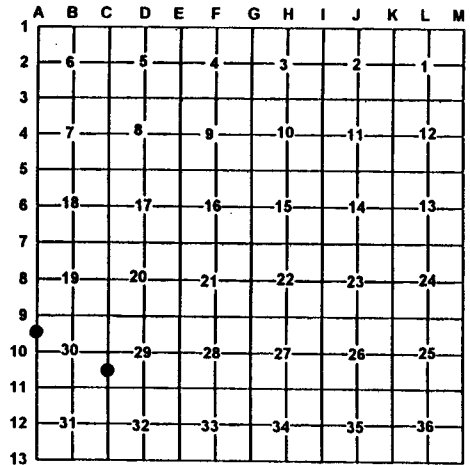

A. Description of original monument and accessories and/or subsequent restoration:

3 - THIS POSITION WAS NOT ESTABLISHED DURING THE ORIGINAL GOVERNMENT SURVEY.

14 - THIS POSITION WAS NOT ESTABLISHED DURING THE ORIGINAL GOVERNMENT SURVEY.

B. Description of corner evidence found and/or method applies in restoring or re-establishing corner:

3 - FOUND AND ACCEPTED A 1/2" ROD AS SET BY LARRY CAVANAGH P.S. # 17614 FOR THE SOUTHWEST CORNER OF THE NORTHWEST QUARTER OF THE NORTHWEST QUARTER OF SECTION 30. THIS POSITION FITS STANDARD B.L.M. INSTRUCTIONS FOR THE SUBDIVISION OF A SECTION.

14 - FOUND AND ACCEPTED 1/2" ROD AS SET BY GEORGE HENNING, R.L.S. #2240 FOR THE NORTHEAST CORNER OF THE SOUTHEAST QUARTER OF THE SOUTHEAST QUARTER OF SECTION 30. THIS POSITION FITS STANDARD B.L.M. INSTRUCTIONS FOR THE SUBDIVISION OF A SECTION.

C. Description of monument for corner and accessories established to perpetuate locating the position of the corner:

3 - 1/2" ROD - SET CARSONITE POST SOUTH 1'.

WIT: 3" OAK	S74° W	38.08'
7" OAK	S28° E	22.20'
14" OAK	N73° E	35.66'
4" OAK	N11° W	78.18'

14 - SET 1"X32" PIPE WITH P.S.CAP AND CARSONITE POST.

WIT: 5" MAPLE	S32° W	7.43'
4" OAK	S35° W	2.45'
7" OAK	N66° E	13.29'
3" BALSAM	S28° E	47.35'
CARSONITE POST	NORTH	1'

Signed by: _____

Carl T. Kiiskila

Date: _____

6-22-99

Surveyor's Michigan License No.: _____

33981

