

MAY 28 1997

COMMISSION

LAND CORNER RECORDATION CERTIFICATE
Filing Requirement of Act 74, Mich. P.A. 1970

For corners in Roscommon (County) Located in: Corner Code #

- 1. Public Land Survey T 23N R 3W T 23N R 2W M-11 A-11
2. Property Controlling in Section S T R
3. Miscellaneous Property in Section S T R
4. Lot No. Recorded Plat
5. Private Claims

STATE OF MICHIGAN ROSCOMMON COUNTY RECORDED 26 SEP 96 3:36 P.M. ROBERT W. SMITH REGISTER OF DEEDS TO BE FILED IN LIBER 3 OF LAND CORNERS Register of Deeds Stamp & File Number

I, Larry L. Cavanagh, in a field survey on August, 19 96, do hereby certify that under requirements of P.A. 74, Michigan P.A. of 1970, the corner points mentioned in lines 1 and 2 above were in conformance with regulations and rules therefore as required in the current manual of survey instructions of the United States Department of the Interior, Bureau of Land Management or by a decree of a Court of Law and/or that the corner points mentioned in lines 3, 4 and 5 above were in conformance with the rules of the Michigan Board of Professional Surveyors or by a Decree of a Court of Law; established, re-established, monumented, re-monumented, recovered, found as expressed below:

NOTE: Not more than 4 corners, all in the same town and range, may be recorded on this certificate.

Grid table with columns A-M and rows 1-13. Numbers are placed in the grid cells.

A. Description of original monument and accessories and/or subsequent restoration:

- GLO - John Brink 1836 Mon - Hemlock 13" diameter
G. Henning 1955 Sec. Subdivision Mon - 1/2" bar in centerline road .70" North of road intersection
Wit: B.T. 24" Elm N39°W 72.8' B.T. 8" Balsam S78°E 98.4' B.T. 10" Spruce S20°W 14.18'
L. Cavanagh 1-17-79 LCRC LI, Pg 116 Mon - fd. 1/2" bar Wit: 24" Elm N39°W 72.8 3" Balsam S78°E 78.4 10" Spruce S20°W 141.8
C. Johnson 1-1-92 LCRC LI, Pg 308 Mon - fd 1/2" bar Wit: 8" W. Pine S82°E 53.47' 5" W. Pine N49°E 54.56' 24" Ash N44°W 73.10' Nail w/ref. tags
C. Roser 5-4-94 LCRC LI, Pg 328 Mon - fd. 1/2" bar Wit: same as above
C. Lindgren 1-10-93 LCRC LI, Pg 331 Mon - fd. barn spike raised w/p.k. nail at surface Wit: fd. Nail & DNR tag 8" W. Pine N45°E 54.21' fd. Nail & DNR tag 15" W. Pine East 53.43' fd. Nail & DNR tag 24" Willow N45°W 72.92' N/tag in pole N80°W 65.36' 1" pin in mon. box raised w/boatspike S05°W 57.24'

B. Description of corner evidence found and/or method applied in restoring or reestablishing corner:

Found p.k. nail over 3/8" x 1' cabin spike Wit: fd. nail with DNR tags Power Pole N86°W 65.37' 5" W. Pine N45°E 54.20' 14" W. Pine S88°E 53.43' 24" Elm stump N48°W 72.86'


ROSCOMMON COUNTY PEER GROUP APPROVAL

DATE August 19, 1996

Marvin E. Myers, P.S. County Surveyor

C. Description of monument for corner and accessories established to perpetuate locating the position of the corner:

The best available evidence of the position of the Original Corner. Mon - set standard Roscommon County Monument Brass cap stamped 1996, #17614 in pav't box on centerline Wit: Fd. Nails w/ DNR Tags Power Pole N86°W 65.37' 5" White Pine N45°E 54.20' 14" White Pine S88°E 53.43' 24" Elm Stump N48°W 72.86' Set Nail & Tag 8" Ash N43°W 93.80' Boat spike near centerline of road West 57.28' South of section corner, 2' West of M-18 centerline Carsonite post 36.7' East

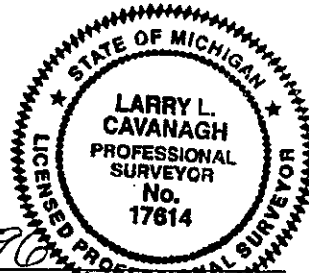

Signed by [Signature] Surveyor's Michigan License No. 17614

Date 9-16-96