

4547

APR 07 1998

LAND CORNER RECORDATION CERTIFICATE  
Filing Requirement of Act 74, Mich. P.A. 1970

For corners in

FILE IN LIBER 3 OF LAND CORNERS SECTION

Rescommon (County)	Located In:	Corner Code #
1. Public Land Survey	T 23N R 2W	B-7
	T _____ R _____	_____
	T _____ R _____	_____
	T _____ R _____	_____
2. Property Controlling in Section	S _____ T _____ R _____	_____
	S _____ T _____ R _____	_____
3. Miscellaneous Property in Sec.	S _____ T _____ R _____	_____
	S _____ T _____ R _____	_____
4. Lot No. _____, Recorded Plat _____		
5. Private Claims _____		

STATE OF MICHIGAN  
ROSCOMMON COUNTY  
RECORDED  
10 JUL 97 2:14 P.M.  
ROBERT W. SMITH  
REGISTER OF DEEDS & FILE NUMBER

I, Marvin E. Myers, in a field survey on 2 June, 1997, do hereby certify that under requirements of P.A. 74, Michigan P.A. of 1970, the corner points mentioned in lines 1 and 2 above were in conformance with regulations and rules therefore as required in the current manual of survey instructions of the United States Department of the Interior, Bureau of Land Management or by a decree of a Court of Law and/or that the corner points mentioned in lines 3, 4 and 5 above were in conformance with the rules of the Michigan Board of Land Surveyors or by a Decree of a Court of Law; established, re-established, monumented, re-monumented, recovered, found as expressed below:

	A	B	C	D	E	F	G	H	I	J	K	L	M
2	6	5	4	3	2	1							
3													
4	7	8	9	10	11	12							
5													
6	18	17	16	15	14	13							
7													
8	19	20	21	22	23	24							
9													
10	30	29	28	27	26	25							
11													
12	31	32	33	34	35	36							
13													

**NOTE: Not more than 4 corners, all in the same town and range, may be recorded on this certificate.**


A. Description of original monument and accessories and/or subsequent restoration:  
 GLO-John Brink 1852 DNR- Schaaf - 1935±  
 Mon-Post Mon. -  
 WIT: 12" Beech N37°W 42 lks. Found or established, and replaced  
 10" Hemlock S83°E 41 lks.  
 Larry L. Cavanagh P.S. #17614 Frank J. Arieth, P.S. #21266  
 Liber 1 Page 265 10-2-89 10-18-96  
 Set 1/2" x 18" steel bar WIT: 5" Oak N45°E 7.15'  
 WIT: N54°E 5" Oak 7.15' 5" Oak S19°E 17.32'  
 S19°E 5" Oak 17.32' Cor. of Cabin S61°W 10.95'  
 S61°W corner of cabin 10.75' 6" Spruce N58°W 34.45'  
 N58°W 6" Spruce 34.45'

Aug 18, 1945 G.D. Henning  
Mon- found pipe  
 March 25, 1949 G. D. Henning  
Mon- found 1 1/2" pipe and post

B. Description of corner evidence found and/or method applied in restoring or reestablishing corner:  
 Found 1/2" x 18" steel bar set in old 3" x 4" wood post. Found and verified position from accessories recorded in L. 1, P. 265 and accepted as the best available evidence of the position of the Original Corner.

ROSCOMMON COUNTY  
PEER GROUP APPROVAL  
DATE July 8, 1997  
*Marvin E. Myers*  
Marvin E. Myers, P.S.  
County Surveyor

C. Description of monument for corner and accessories established to perpetuate locating the position of the corner:  
 Mon. - Std. 22" Roscommon County Mon.  
 WIT: nail & tag S. side 7" Oak N60°E 7.32'  
 nail & tag SW. side 6" Oak S16°E 11.46'  
 NE. Cor. cabin S63°W 10.75'  
 nail & tag NW. side 24" Black Oak N60°E 47.00'  
 Set Carsonite post East 6.5'

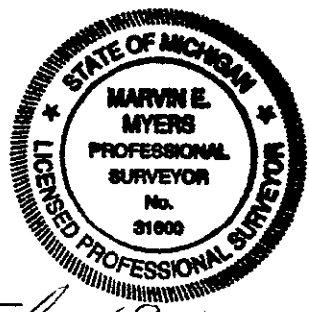

Signed by *Marvin E. Myers* Date July 9, 1997  
 Surveyor's Michigan License No. 31600

LIBER 3 PAGE 402