

4621

LAND CORNER RECORDATION CERTIFICATE
Filing Requirement of Act 74, Mich P.A. 1970

For corners in
Roscommon County

Located in: Corner Code #

1. Public Land Survey

| | | |
|------|------|------|
| T23N | R 2W | E-1 |
| T24N | R2W | E-13 |
| T | R | |
| T | R | |

STATE OF MICHIGAN
ROSCOMMON COUNTY
RECORDED

11 JUL 97 4:11 P.M.

ROBERT W. SMITH
REGISTER OF DEEDS

I, Larry L. Cavanagh, in a field survey June 20, 1997, do hereby certify that under requirements of P.A. 74, Michigan P.A. of 1970, the corner points mentioned in line 1 above was in conformance with regulations and rules therefore as required in the current manual of survey instructions of the United States Department of the Interior, Bureau of Land Management or by a decree of a Court of Law; established, re-established, monumented, recovered, found as expressed below:

Register of Deeds Stamp & File Number

| | A | B | C | D | E | F | G | H | I | J | K | L | M |
|----|----|----|----|----|----|----|---|---|---|---|---|---|---|
| 2 | 6 | 5 | 4 | 3 | 2 | 1 | | | | | | | |
| 3 | | | | | | | | | | | | | |
| 4 | 7 | 8 | 9 | 10 | 11 | 12 | | | | | | | |
| 5 | | | | | | | | | | | | | |
| 6 | 18 | 17 | 16 | 15 | 14 | 13 | | | | | | | |
| 7 | | | | | | | | | | | | | |
| 8 | 19 | 20 | 21 | 22 | 23 | 24 | | | | | | | |
| 9 | | | | | | | | | | | | | |
| 10 | 30 | 29 | 28 | 27 | 26 | 25 | | | | | | | |
| 11 | | | | | | | | | | | | | |
| 12 | 31 | 32 | 33 | 34 | 35 | 36 | | | | | | | |
| 13 | | | | | | | | | | | | | |

A. Description of original monument and accessories and/or subsequent restoration:

SET POST BY WILLIAM BURT, 1852
WIT: Y. PINE N68E 42
Y. PINE N46W 24

SCHAAF RECORD INDICATES
FOUND AND REPLACED

(IN OLD 14"x17" SURVEY BOOK REG
OF DEEDS)
DELAMATER 1929
FD GOV'T B.T.S & POST
W. PINE ST. 30" N79°E 64.0'
Y. PINE ST. 14" S43°W 62.0'

KENNETH J. OSTLING RLS 10068, LCRC 1983
LEFT 1 1/4" PIPE IN CONCRETE
9" R. OAK N10°E 24.7'
12" R. OAK S56°E 49.5'
SET 5" CEDAR POST W/LOCATION TAG BY
CORNER

B. Description of corner evidence found and/or method applied in restoring or reestablishing corner:

FOUND 1 1/4" PIPE IN CONCRETE
WITNESSES 2, 3 AND 4 (LISTED BELOW) WERE FOUND AND USED. DNR TAGS
NO RECORD FOUND


C. Description of monument for corner and accessories established to perpetuate locating the position of the corner:

SET ROSCOMMON COUNTY MONUMENT #17614 1997
7" POPLAR N54°E 19.53' ROSC. COUNTY TAG & NAIL (1)
16" TWIN R. OAK N32°W 25.27' DNR TAG & NAIL (2)
10" R. OAK N55°E 25.15' DNR TAG & NAIL (3)
6" R. OAK S82°W 27.78' WITH DNR TAG & NAIL (4)
CARSONITE POST WEST 1.5'

A PERPETUATION OF THE ORIGINAL GOVERNMENT CORNER.

ROSCOMMON COUNTY
PEER GROUP APPROVAL
DATE July 8, 1997

Marvin E. Myers
Marvin E. Myers, P.S.
County Surveyor

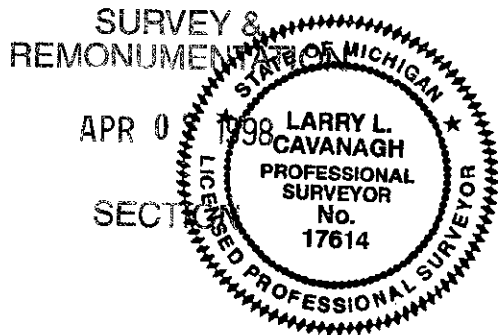

Signed by *Larry L. Cavanagh*
Surveyor's Michigan License NO. 17614

Date July 9, 1997

FORM APPROVED BY MICHIGAN STATE BOARD OF LAND SURVEYORS, JAN 28, 1971
REVISED MAY 14, 1975
REVISED JAN., 1983

LIBER 3 PAGE 414