

4552

APR 07 1998

LAND CORNER RECORDATION CERTIFICATE
Filing Requirement of Act 74, Mich. P.A. 1970

For corners in Roscommon (County) Located In: Corner Code #
1. Public Land Survey T 23N R 2W G-7
2. Property Controlling in Section S T R
3. Miscellaneous Property in Section S T R

SECTION STATE OF MICHIGAN ROSCOMMON COUNTY RECORDED

10 JUL 97 2:15 P.M.

ROBERT W. SMITH REGISTER OF DEEDS

FILE IN LIBER 3 OF LAND CORNERS Register of Deeds Stamp & File Number

4. Lot No. , Recorded Plat
5. Private Claims

I, Marvin E. Myers, in a field survey on 12 June, 19 97, do hereby certify that under requirements of P.A. 74, Michigan P.A. of 1970, the corner points mentioned in lines 1 and 2 above were in conformance with regulations and rules therefore as required in the current manual of survey instructions of the United States Department of the Interior, Bureau of Land Management or by a decree of a Court of Law and/or that the corner points mentioned in lines 3, 4 and 5 above were in conformance with the rules of the Michigan Board of Professional Surveyors or by a Decree of a Court of Law; established, re-established, monumented, re-monumented, recovered, found as expressed below:

Grid table with columns A-M and rows 2-13. A dot is marked at the intersection of column G and row 7.

NOTE: Not more than 4 corners, all in the same town and range, may be recorded on this certificate.

A. Description of original monument and accessories and/or subsequent restoration:

GLO - John Brink 1852
Mon. - Post
WIT: 6" Tamarack N42°E 4 lks
4" Tamarack S36°W 17 lks

DNR - Schaaf - 1935±
Mon. -
Found or established, and replaced

B. Description of corner evidence found and/or method applied in restoring or reestablishing corner:


Found 1 1/2" Pipe (typical Schaaf monument) accepted as the best available evidence of the position of the Original corner. replaced 1 1/2" pipe with new 3/4"x5' pipe and cap marked "MEM 31600"

ROSCOMMON COUNTY PEER GROUP APPROVAL DATE July 8, 1997

Marvin E. Myers, P.S. County Surveyor

C. Description of monument for corner and accessories established to perpetuate locating the position of the corner:

Mon. - 3/4" x 5' pipe with cap #31600
WIT: spike E. side 4" Tamarack N78°E 8.42'
spike N. side 3" Tamarack N40°W 1.93'
spike S. side 3" Tamarack S39°E 11.60'
spike W. side 4" Tamarack S29°W 20.00'

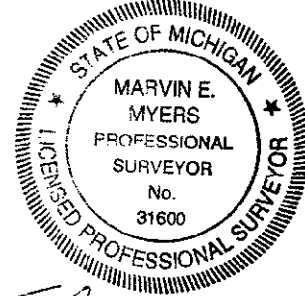

Signed by Marvin E. Myers
Surveyor's Michigan License No. 31600

Date July 9, 1997

LIBER 3 PAGE 407