

APR 07 1998

4553

LAND CORNER RECORDATION CERTIFICATE  
Filing Requirement of Act 74, Mich. P.A. 1970


STATE OF MICHIGAN  
ROSCOMMON COUNTY  
RECORDED

10 JUL 97 2:15 P.M.

ROBERT W. SMITH  
REGISTER OF DEEDS

FILE IN LIBER 3 OF LAND CORNERS  
Register of Deeds Stamp & File Number

For corners in	Located In:	Corner Code #
Roscommon (County)		
1. Public Land Survey	T <u>23N</u> R <u>2W</u>	<u>H-7</u>
	T _____ R _____	_____
	T _____ R _____	_____
	T _____ R _____	_____
2. Property Controlling in Section	S _____ T _____ R _____	_____
	S _____ T _____ R _____	_____
3. Miscellaneous Property in Section	S _____ T _____ R _____	_____
	S _____ T _____ R _____	_____
4. Lot No. _____, Recorded Plat _____		
5. Private Claims _____		

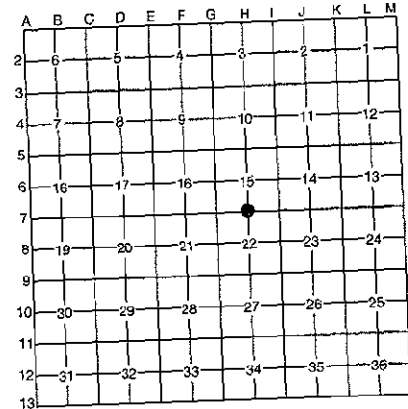

I, Marvin E. Myers, in a field survey on 12 June, 1997, do hereby certify that under requirements of P.A. 74, Michigan P.A. of 1970, the corner points mentioned in lines 1 and 2 above were in conformance with regulations and rules therefore as required in the current manual of survey instructions of the United States Department of the Interior, Bureau of Land Management or by a decree of a Court of Law and/or that the corner points mentioned in lines 3, 4 and 5 above were in conformance with the rules of the Michigan Board of Professional Surveyors or by a Decree of a Court of Law; established, re-established, monumented, re-monumented, recovered, found as expressed below:

**NOTE: Not more than 4 corners, all in the same town and range, may be recorded on this certificate.**

A. Description of original monument and accessories and/or subsequent restoration:

GLO - John Brink 1852  
Mon. - Post  
WIT: 5" Cedar N41°W 16 lks.  
5" Cedar S42E 17 lks.

DNR - Schaaf - 1935±  
Mon. -  
Found or established, and replaced

B. Description of corner evidence found and/or method applied in restoring or reestablishing corner:

Found 1½" pipe (typical Schaaf monument) and is accepted as the best available evidence of the position of the Original Corner. Replaced 1½" Schaaf pipe with new ¾"x5" pipe & cap marked "MEM 31600"

ROSCOMMON COUNTY  
PEER GROUP APPROVAL  
DATE July 8, 1997

Marvin E. Myers  
Marvin E. Myers, P.S.  
County Surveyor

C. Description of monument for corner and accessories established to perpetuate locating the position of the corner:

Mon. - ¾" x 5" pipe with cap #31600  
WIT: spike N. side 24" Maple S73°W 22.74'  
spike W. side 3" W. Pine S01°E 14.87'  
spike NE. side 3" Spruce S86°E 21.88'  
spike SE side 4" Spruce N49°E 4.15'  
Carsonite Post N28°E 0.76'



Signed by Marvin E. Myers  
Surveyor's Michigan License No. 31600

Date July 9, 1997

FORM APPROVED BY MICHIGAN STATE BOARD OF PROFESSIONAL SURVEYORS, JAN. 28, 1971  
REVISED MAY 14, 1975  
REVISED JAN., 1983