

4628

LAND CORNER RECORDATION CERTIFICATE
Filing Requirement of Act 74, Mich P.A. 1970

For corners in
Roscommon County

Located in: Corner Code #

1. Public Land Survey

T23N R2W L-1
T24N R2W L-13
T R
T R

STATE OF MICHIGAN
ROSCOMMON COUNTY
RECORDED

11 JUL 97 4:12 P.M.

ROBERT W. SMITH
REGISTER OF DEEDS

Register of Deeds Stamp & File Number

I, Larry L. Cavanagh, in a field survey June 20, 1997, do hereby certify that under requirements of P.A. 74, Michigan P.A. of 1970, the corner points mentioned in line 1 above was in conformance with regulations and rules therefore as required in the current manual of survey instructions of the United States Department of the Interior, Bureau of Land Management or by a decree of a Court of Law; established, re-established, monumented, recovered, found as expressed below:

A. Description of original monument and accessories and/or subsequent restoration:

SET POST BY WILLIAM BURT, 1852
WIT: HEMLOCK 6 N55W 3
W. PINE 24 N42E 49

Grid table with columns A-L and rows 2-13. Contains numbers 6-36 in a grid pattern.

B. Description of corner evidence found and/or method applied in restoring or reestablishing corner:

NO ORIGINAL EVIDENCE WAS FOUND.
FOUND 1 1/2" PIPE, SIMILAR TO PIPE FOUND AT M-1, NO WRITTEN RECORD WAS FOUND.
L-1 TO K-1 S89°02'47"W 2644.43'
L-1 TO M-1 IS N88°49'40"E 2648.43'
THIS PIPE IS ACCEPTED AS THE BEST AVAILABLE EVIDENCE.
POSSIBLY SET BY M. SCHAAP

C. Description of monument for corner and accessories established to perpetuate locating the position of the corner:

SET ROSCOMMON COUNTY MONUMENT #17614 1997
WIT: NAIL & TAG IN 14" J. PINE N35°W 36.24'
NAIL & TAG IN 4" B. OAK N42°E 23.64'
NAIL & TAG IN 8" BALSAM S55°E 20.11'
NAIL & TAG IN CLUMP OF 4" BLASAMS S30°W 4.29'
CARSONITE POST NORTH 1.35'

THE BEST AVAILABLE EVIDENCE OF THE POSITION OF THE ORIGINAL CORNER.


SURVEY &
REMONUMENTATION

APR 07 1998

SECTION

ROSCOMMON COUNTY
PEER GROUP APPROVAL
DATE July 8, 1997

Marvin E. Myers, P.S.
County Surveyor

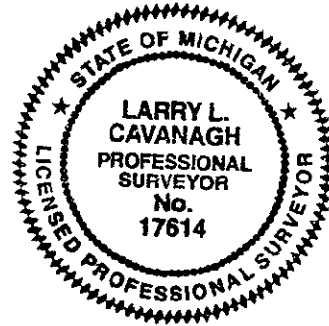

Signed by Larry L. Cavanagh Date July 9, 1997
Surveyor's Michigan License NO. 17614

FORM APPROVED BY MICHIGAN STATE BOARD OF LAND SURVEYORS, JAN 28, 1971
REVISED MAY 14, 1975
REVISED JAN., 1983

LIBER 3 PAGE 421