

025

SURVEY & REMONUMENTATION

MAY 28 1997

LAND CORNER RECORDATION CERTIFICATE COMMISSION

Filing Requirement of Act 74, Mich. P.A. 1970

For corners in Roscommon (County)	Located in:	Corner Code #
1. Public Land Survey	T 23N R 2W	L - 7
	T _____ R _____	_____
	T _____ R _____	_____
	T _____ R _____	_____
2. Property Controlling in Section	S _____ T _____ R _____	_____
	S _____ T _____ R _____	_____
3. Miscellaneous Property in Section	S _____ T _____ R _____	_____
	S _____ T _____ R _____	_____

STATE OF MICHIGAN
 ROSCOMMON COUNTY
 RECORDED
 17 JUN 96 3:40 P.M.
 ROBERT W. SMITH
 REGISTER OF DEEDS
 Register of Deeds Stamp & File Number

4. Lot No. _____, Recorded Plat _____
 5. Private Claims _____

I, Marvin E. Myers, in a field survey on APRIL 10, 191996, do hereby certify that under requirements of P.A. 74, Michigan P.A. of 1970, the corner points mentioned in lines 1 and 2 above were in conformance with regulations and rules therefore as required in the current manual of survey instructions of the United States Department of the Interior, Bureau of Land Management or by a decree of a Court of Law and/or that the corner points mentioned in lines 3, 4 and 5 above were in conformance with the rules of the Michigan Board of Professional Surveyors or by a Decree of a Court of Law; established, re-established, monumented, re-monumented, recovered, found as expressed below:

NOTE: Not more than 4 corners, all in the same town and range, may be recorded on this certificate.

A. Description of original monument and accessories and/or subsequent restoration:

GLO-William Burt 1852 Mon-Set Post WIT: 12" Y. Birch N70°W 13 lks. 6" B. Ash S63°E 10 lks.	G.D. Henning Feb. 9, 1946 Mon-Set 4" Sq. Cedar Post 20' South of random line WIT: Mkd. BT on 8" Aspen N78°W 15.70' Mkd. BT on 8" Aspen N30°W 32.00' Mkd. BT on 8" Aspen N06½°E 22.10'
---	--

B. Description of corner evidence found and/or method applied in restoring or reestablishing corner:

No evidence of cedar post or accessories found. Reestablished on line single proportion measure.


	A	B	C	D	E	F	G	H	I	J	K	L	M
2	6		5		4		3		2		1		
3													
4	7		8		9		10		11		12		
5													
6	18		17		16		15		14		13		
7													
8	19		20		21		22		23		24		
9													
10	30		29		28		27		26		25		
11													
12	31		32		33		34		35		36		
13													

ROSCOMMON COUNTY
 PEER GROUP APPROVAL
 DATE MAY 18, 1996

Marvin E. Myers
 Marvin E. Myers, P.S.
 County Surveyor

C. Description of monument for corner and accessories established to perpetuate locating the position of the corner:

Monument - Set standard Roscommon County monument stamped "31600"
 WIT: Set nail & tag SE side 5" Ash S31°W 12.67'
 Set nail & tag E. side 4" Ash S20°E 25.00'
 Set nail & tag SE side 6" Ash N47°E 8.16'
 Set nail & tag NE side 6" Ash N30°W 11.60'
 Set carsonite post West 1.00'

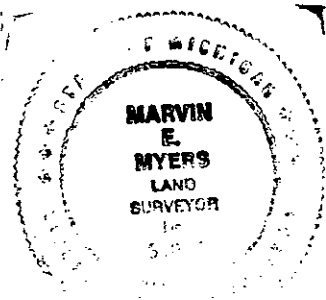

Signed by *Marvin E. Myers*
 Surveyor's Michigan License No. 31600

Date MAY 18, 1996