

**SURVEY &
REMONUMENTATION**

APR 07 1998

SECTION

9239

LAND CORNER RECORDATION CERTIFICATE
Filing Requirement of Act 74, Mich P.A. 1970

STATE OF MICHIGAN
ROSCOMMON COUNTY
RECORDED

16 DEC 97 12:24 P.M.

ROBERT W. SMITH
REGISTER OF DEEDS

For corners in
Roscommon County

Located in: Corner Code #

1. Public Land Survey

T23N	R 1W	A-12
T23N	R 2W	M-12
T	R	
T	R	

FILE IN LIBER 3 OF LAND CORNER.

Register of Deeds Stamp & File Number

I, Larry L. Cavanagh, in a field survey November, 1997, do hereby certify that under requirements of P.A. 74, Michigan P.A. of 1970, the corner points mentioned in line 1 above was in conformance with regulations and rules therefore as required in the current manual of survey instructions of the United States Department of the Interior, Bureau of Land Management or by a decree of a Court of Law; established, re-established, monumented, recovered, found as expressed below:

	A	B	C	D	E	F	G	H	I	J	K	L	M
2	6	5	4	3	2	1							
3													
4	7	8	9	10	11	12							
5													
6	18	17	16	15	14	13							
7													
8	19	20	21	22	23	24							
9													
10	30	29	28	27	26	25							
11													
12	31	32	33	34	35	36							

A. Description of original monument and accessories and/or subsequent restoration:

JOHN BRINK 1838
SET POST
W. BIRCH 5" S26W 8 LKS
MAPLE 5" N76W 23 LKS

B. Description of corner evidence found and/or method applied in restoring or reestablishing corner:

FOUND 1/2" X 18" BAR AT MID-POINT
BEARING/DISTANCE A-11 TO A-12 80°12'57"W 2648.56'
BEARING/DISTANCE A-13 TO A-12 N0°12'57"E 2648.56'


C. Description of monument for corner and accessories established to perpetuate locating the position of the corner:

SET ROSCOMMON COUNTY MONUMENT STAMPED 17614, 1997
NAIL & TAG IN 6" MAPLE S60°E 48.20'
NAIL & TAG IN 17" W. PINE N28°E 67.91'
NAIL & TAG IN 10" CEDAR N76°W 50.86'
NAIL & TAG IN 8" MAPLE S39°W 84.50'
CARSONITE POST EAST 24.40'

THE BEST AVAILABLE EVIDENCE OF THE POSITION OF THE ORIGINAL CORNER.

ROSCOMMON COUNTY
PEER GROUP APPROVAL
DATE DEC 5, 1997

Marvin E. Myers
Marvin E. Myers, P.S.
County Surveyor

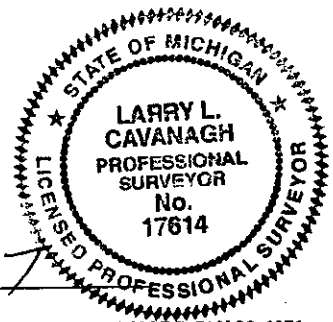

Signed by *Larry L. Cavanagh*
Surveyor's Michigan License NO. 17614

Date Dec. 11, 1997

FORM APPROVED BY MICHIGAN STATE BOARD OF LAND SURVEYORS, JAN 28, 1971
REVISED MAY 14, 1975
REVISED JAN., 1983

LIBER 3 PAGE 464