

**LAND CORNER RECORDATION CERTIFICATE**  
**Filing Requirement of Act 74, Mich. P.A. 1970**

For corners in

<u>Roscommon</u> <small>(County)</small>	Located In:	Corner Code =#
1. Public Land Survey	T <u>23</u> R <u>3W</u>	<u>M-7</u>
	T <u>23</u> R <u>3W</u>	<u>M-8</u>
	T <u>23</u> R <u>3W</u>	<u>M-9</u>
	T <u>23</u> R <u>3W</u>	<u>M-10</u>
2. Property Controlling in Section	S _____ T _____ R _____	_____
	S _____ T _____ R _____	_____
3. Miscellaneous Property in Sec.	S _____ T _____ R _____	_____
	S _____ T _____ R _____	_____

Register of Deeds Stamp & File Number

4. Lot No. \_\_\_\_\_, Recorded Plat \_\_\_\_\_  
 5. Private Claims \_\_\_\_\_

I, Carl Johnson, in a field survey on June 26, 1991, do hereby certify that under requirements of P.A. 74, Michigan P.A. of 1970, the corner points mentioned in lines 1 and 2 above were in conformance with regulations and rules therefore as required in the current manual of survey instructions of the United States Department of the Interior, Bureau of Land Management or by a decree of a Court of Law and/or that the corner points mentioned in lines 3, 4 and 5 above were in conformance with the rules of the Michigan Board of Land Surveyors or by a Decree of a Court of Law, established, re-established, monumented, re-monumented, recovered, found as expressed below:

**NOTE: Not more than 4 corners, all in the same town and range, may be recorded on this certificate.**


	A	B	C	D	E	F	G	H	I	J	K	L	M
2	6	5	4	3	2	1							
3													
4	7	8	9	10	11	12							
5													
6	18	17	16	15	14	13							
7													
8	19	20	21	22	23	24							
9													
10	30	29	28	27	26	25							
11													
12	31	32	33	34	35	36							
13													

A. Description of original monument and accessories and/or subsequent restoration:

*GRAYLING F.O.  
517-348-6371*

B. Description of corner evidence found and/or method applied in restoring or reestablishing corner:

- M-7 - Found and accepted this survey. Found witnesses from Henning Survey 1955.
- M-8 - Found and accepted this survey. Found witnesses from Henning Survey 1955.
- M-9 - Found and accepted this survey. Found witnesses from Henning Survey 1955.
- M-10 - Found and accepted this survey. Found witnesses from Henning Survey 1955.

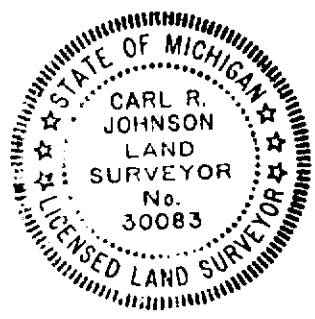

C. Description of monument for corner and accessories established to perpetuate locating the position of the corner:

<u>M-7: NE Corner</u>	<u>M-8: E 1/4 Corner</u>	<u>M-9: NE Corner</u>	<u>M-10: E 1/4 Corner</u>
Fd railroad spike	1 1/4" pipe raised w/ 5/8" bar	Fd 1/2" bar	Fd 1/2" bar
6" Pine S56°E 70.75'	8" Red Oak N78°W 38.69'	24" Cedar N24°W 87.75'	12" White Pine N50°W 42.20'
6" Tamarack N54°E 86.30'	6" Red Oak S82°W 44.97'	10" Red Oak N80°E 55.33'	14" White Pine S36°W 69.66'
10" Pine S89°W 84.45'	8" Ironwood N72°E 51.68'	8" Red Oak S74°E 50.30'	8" White Pine S64°E 51.50'
6" Cedar S54°W 81.75'	10" Maple S27°E 83.10'	Nail w/ref. tags	8" White Pine N80°E 50.50'
Nail w/ref. tags	Nail w/ref. tags		Nail w/ref. tags
	1 1/4" pipe S72°W 33.55'		

Signed by

*Carl Johnson*

Date

1/28/92

Surveyor's Michigan License No.

30083