

**LAND CORNER RECORDATION CERTIFICATE**  
**Filing Requirement of Act 74, Mich. P.A. 1970**

For corners in

<u>Roscommon</u> (County)	Located In:	Corner Code #
1. Public Land Survey	T <u>23</u> R <u>3W</u>	<u>M-11</u>
	T <u>23</u> R <u>3W</u>	<u>L-11</u>
	T <u>23</u> R <u>3W</u>	<u>K-11</u>
	T <u>23</u> R <u>3W</u>	<u>L-7</u>
2. Property Controlling in Section	S _____ T _____ R _____	_____
	S _____ T _____ R _____	_____
3. Miscellaneous Property in Sec.	S _____ T _____ R _____	_____
	S _____ T _____ R _____	_____
4. Lot No. _____, Recorded Plat _____		
5. Private Claims _____		

Register of Deeds Stamp & File Number

I, Carl Johnson, in a field survey on June 26, 19 91, do hereby certify that under requirements of P.A. 74, Michigan P.A. of 1970, the corner points mentioned in lines 1 and 2 above were in conformance with regulations and rules therefore as required in the current manual of survey instructions of the United States Department of the Interior, Bureau of Land Management or by a decree of a Court of Law and/or that the corner points mentioned in lines 3, 4 and 5 above were in conformance with the rules of the Michigan Board of Land Surveyors or by a Decree of a Court of Law; established, re-established, monumented, re-monumented, recovered, found as expressed below:


**NOTE: Not more than 4 corners, all in the same town and range, may be recorded on this certificate.**

	A	B	C	D	E	F	G	H	I	J	K	L	M
2	6		5		4		3		2		1		
3													
4	7		8		9		10		11		12		
5													
6	18		17		16		15		14		13		
7													
8	19		20		21		22		23		24		
9													
10	30		29		28		27		26		25		
11													
12	31		32		33		34		35		36		
13													

A. Description of original monument and accessories and/or subsequent restoration:

B. Description of corner evidence found and/or method applied in restoring or reestablishing corner:

- M-11 - Found and accepted as recorded.
- L-11 - Set midway and on line between found section corners.
- K-11 - Found and accepted as recorded.
- L-7 - Set midway and on line between found section corners.

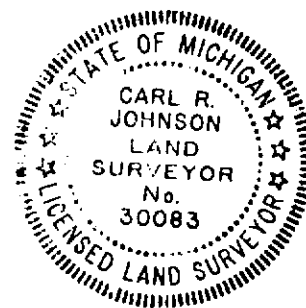

C. Description of monument for corner and accessories established to perpetuate locating the position of the corner:

<u>M-11: SE Corner</u>	<u>L-11: S<math>\frac{1}{4}</math> Corner Sec 25</u>	<u>K-11: SW Corner</u>	<u>L-7: S<math>\frac{1}{4}</math> Corner Sec 13</u>
Fd $\frac{1}{2}$ " bar	Set DNR Mon & cedar post	Fd $\frac{1}{2}$ " bar in Mon. Box	DNR Mon & Cedar Post
8" White Pine S82°E 53.47'	Ash 5" N61°W 36.5'	12" Red Pine N56°W 48.60'	Maple 12" South 25.0'
5" White Pine N49°E 54.56'	White Birch 4" N31°E 12.4'	6" Maple S85°W 44.45'	Maple 7" S42°W 33.8'
24" Ash N44°W 73.10'	Maple 4" N84°E 17.7'	8" Red Pine N49°E 31.00'	Twin Oak 20" N10°W 6.1'
Nail with ref. tags.	Blacktop road south 50.6'	Fence Corner S70°E 26.45'	Oak 12" N80°E 13.1'
	Upper & Lower Blazes & Scribes	Nail w/ref. tags.	Upper & Lower Blazes w/scri

Signed by Carl Johnson Date 1/28/92  
 Surveyor's Michigan License No. 30083