

LAND CORNER RECORDATION CERTIFICATE
Filing Requirement of Act 74, Mich. P.A. 1970

For corners in
Roscommon
(County)

Located In: _____ Corner Code ~~##~~

1. Public Land Survey	T <u>23NR</u> <u>3W</u>	<u>K-2</u>
	T <u>23NR</u> <u>3W</u>	<u>M-3</u>
	T _____ R _____	_____
	T _____ R _____	_____
2. Property Controlling in Section	S <u>1</u> T <u>23NR</u> <u>3W</u>	<u>6</u>
	S _____ T _____ R _____	_____
3. Miscellaneous Property in Sec.	S _____ T _____ R _____	_____
	S _____ T _____ R _____	_____

4. Lot No. _____, Recorded Plat _____

5. Private Claims _____

Register of Deeds Stamp & File Number

	A	B	C	D	E	F	G	H	I	J	K	L	M
2	6	5	4	3	2	1							
3													
4	7	8	9	10	11	12							
5													
6	18	17	16	15	14	13							
7													
8	19	20	21	22	23	24							
9													
10	30	29	28	27	26	25							
11													
12	31	32	33	34	35	36							
13													

I, Carl R. Johnson, in a field survey on June 15, 19 89, do hereby certify that under requirements of P.A. 74, Michigan P.A. of 1970, the corner points mentioned in lines 1 and 2 above were in conformance with regulations and rules therefore as required in the current manual of survey instructions of the United States Department of the Interior, Bureau of Land Management or by a decree of a Court of Law and/or that the corner points mentioned in lines 3, 4 and 5 above were in conformance with the rules of the Michigan Board of Land Surveyors or by a Decree of a Court of Law; established, re-established, monumented, re-monumented, recovered, found as expressed below:

NOTE: Not more than 4 corners, all in the same town and range, may be recorded on this certificate.

A. Description of original monument and accessories and/or subsequent restoration:


B. Description of corner evidence found and/or method applied in restoring or reestablishing corner:

- K-2 - Set at Ostling's survey record distance north of found old squared stake for meander corner on N. side of Cut River. Believed to be set by Ostling.
- M-3 - Set by single proportionate measurement between found irons in centerline of M-18 for 1/4 corners north and south.
- 6 - Set by standard survey procedure for subdivision of a section.

C. Description of monument for corner and accessories established to perpetuate locating the position of the corner:

<u>K-2 - W 1/4 Corner Sec. 1</u>	<u>M-3 - SE Corner</u>	<u>6 - Center, NE 1/4 Sec. 1</u>
D.N.R. Monument	5/8" x 18" bar w/cap	5/8" bar w/cap
5" Ash N15°W 21.0'	10" W. Pine N70°E 74.0'	8" R. Pine N1°W 27.0'
7" Maple S25°W 37.4'	4" Cherry S75°E 61.2'	12" R. Pine S75°E 24.4'
	5" Ash S55°W 61.8'	

Signed by Carl R. Johnson
 Surveyor's Michigan License No. 30083

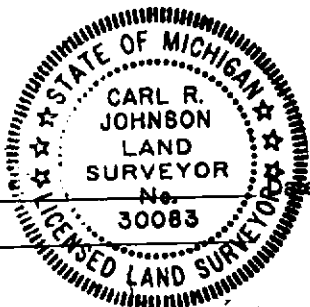

9/21/89
 FORM APPROVED BY MICHIGAN STATE BOARD OF LAND SURVEYORS, JAN. 20, 1971
 REVISED MAY 14, 1975
 REVISED JAN., 1983