

**LAND CORNER RECORDATION CERTIFICATE**  
**Filing Requirement of Act 74, Mich. P.A. 1970**

For corners in

<u>Roscommon</u> (County)	Located In:	Corner Code #
1. Public Land Survey	T <u>23N</u> R <u>3W</u>	<u>K-4</u>
	T _____ R _____	_____
	T _____ R _____	_____
	T _____ R _____	_____
2. Property Controlling in Section	S <u>1</u> T <u>23N</u> R <u>3W</u>	<u>2</u>
	S <u>1</u> T <u>23N</u> R <u>3W</u>	<u>7</u>
3. Miscellaneous Property in Sec.	S _____ T _____ R _____	_____
	S _____ T _____ R _____	_____

Register of Deeds Stamp & File Number

4. Lot No. \_\_\_\_\_, Recorded Plat \_\_\_\_\_  
 5. Private Claims \_\_\_\_\_

I, Carl R. Johnson, in a field survey on June 1, 19 89, do hereby certify that under requirements of P.A. 74, Michigan P.A. of 1970, the corner points mentioned in lines 1 and 2 above were in conformance with regulations and rules therefore as required in the current manual of survey instructions of the United States Department of the Interior, Bureau of Land Management or by a decree of a Court of Law and/or that the corner points mentioned in lines 3, 4 and 5 above were in conformance with the rules of the Michigan Board of Land Surveyors or by a Decree of a Court of Law; established, re-established, monumented, re-monumented, recovered, found as expressed below:

**NOTE: Not more than 4 corners, all in the same town and range, may be recorded on this certificate.**

	A	B	C	D	E	F	G	H	I	J	K	L	M
2	6	5	4	3	2	1							
3													
4	7	8	9	10	11	12							
5													
6	18	17	16	15	14	13							
7													
8	19	20	21	22	23	24							
9													
10	30	29	28	27	26	25							
11													
12	31	32	33	34	35	36							
13													


A. Description of original monument and accessories and/or subsequent restoration:

B. Description of corner evidence found and/or method applied in restoring or reestablishing corner:

- K-4 - Found old squared 4" cedar post by possible original bearing tree SE.
- 2 - Set by standard survey procedure for subdivision of a section.
- 7 - Set by standard survey procedure for subdivision of a section.

C. Description of monument for corner and accessories established to perpetuate locating the position of the corner:

<u>K-4 - W<math>\frac{1}{2}</math> cor. Sec. 12</u>	<u>2 - E<math>\frac{1}{8}</math>, North side Sec. 1</u>
D.N.R. Monument	5/8" bar w/cap
Possible O.B.T. 36" stump S30°E 1.1'	8" R. Oak N20°W 55.4'
6" Cedar S37°E 16.0'	5" W. Pine N82°E 45.9'
6" Ash S55°W 5.6'	7" W. Pine S73°W 14.4'
6" Ash N13°W 21.6'	
<u>7 - N<math>\frac{1}{8}</math>, East side Sec. 1</u>	
5/8" bar w/cap 1.5' long	
Nail & tag in fence post S76°W 75.75'	
Nail & tag in 7" Aspen N37°W 96.72'	
Cedar Post West 66.0'	

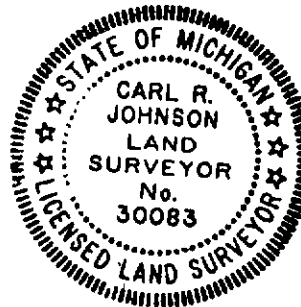

Signed by Carl R. Johnson Date 9/21/89  
 Surveyor's Michigan License No. 30083