

**LAND CORNER RECORDATION CERTIFICATE**  
**Filing Requirement of Act 74, Mich. P.A. 1970**

For corners in  
ROSCOMMON  
 (County)

Located In: \_\_\_\_\_ Corner Code ##


- |                                    |   |              |           |            |
|------------------------------------|---|--------------|-----------|------------|
| 1. Public Land Survey              | T | <u>23N</u> R | <u>3W</u> | <u>1-1</u> |
|                                    | T | _____        | _____     | <u>1-2</u> |
|                                    | T | _____        | _____     | _____      |
|                                    | T | _____        | _____     | _____      |
| 2. Property Controlling in Section | S | <u>2</u> T   | _____     | <u>3</u>   |
|                                    | S | <u>2</u> T   | _____     | <u>10</u>  |
| 3. Miscellaneous Property in Sec.  | S | _____        | _____     | _____      |
|                                    | S | _____        | _____     | _____      |

**Register of Deeds Stamp & File Number**

4. Lot No. \_\_\_\_\_, Recorded Plat \_\_\_\_\_  
 5. Private Claims \_\_\_\_\_

I, CARL R. JOHNSON, in a field survey on JUNE 6, 19 91, do hereby certify that under requirements of P.A. 74, Michigan P.A. of 1970, the corner points mentioned in lines 1 and 2 above were in conformance with regulations and rules therefore as required in the current manual of survey instructions of the United States Department of the Interior, Bureau of Land Management or by a decree of a Court of Law and/or that the corner points mentioned in lines 3, 4 and 5 above were in conformance with the rules of the Michigan Board of Land Surveyors or by a Decree of a Court of Law, established, re-established, monumented, re-monumented, recovered, found as expressed below:

**NOTE: Not more than 4 corners, all in the same town and range, may be recorded on this certificate.**

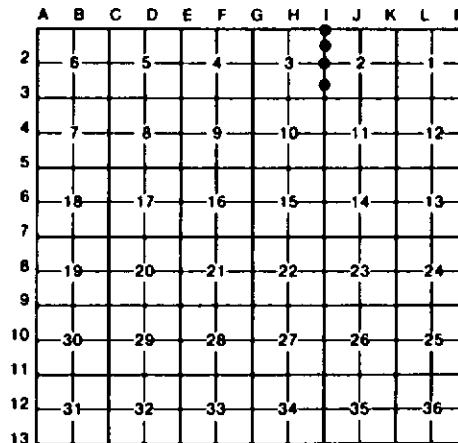


A. Description of original monument and accessories and/or subsequent restoration:

1-1                                      1-2                                      3                                      10

B. Description of corner evidence found and/or method applied in restoring or reestablishing corner:

1-1	1-2	3	10
SET BY SINGLE PROPORTIONATE MEASUREMENT BETWEEN FOUND 1/4 CORNERS EAST AND WEST	SET BY SINGLE PROPORTIONATE MEASUREMENT BETWEEN SECTION CORNERS.	SET BY STANDARD PROCEDURE FOR SUBDIVISION OF A SECTION.	SET BY STANDARD PROCEDURE FOR SUBDIVISION OF A SECTION.

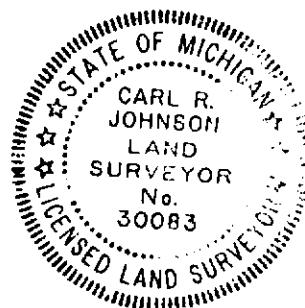

C. Description of monument for corner and accessories established to perpetuate locating the position of the corner:

1-1	1-2	3	10
NE CORNER SEC. 3 DNR MON.	1/4 COR. COMMON TO SEC. 2&3 DNR MON.	N1/8 COR. ON W. LINE SEC. 2 5/8" BAR W/CAP	S1/8 COR. ON W. LINE SEC. 2 5/8" BAR W/CAP
MAPLE 8" N15W 10.2 FT. MAPLE 7" N69W 24.6 FT. MAPLE 5" N88W 21.0 FT. ASH 4" S23W 6.8 FT.	MAPLE 8" N26E 24.8 FT. TWIN R.OAK 12" S35E 11.1 FT. R.OAK 8" S75W 26.0 FT. R.OAK 6" N11W 27.6 FT.	MAPLE 10" N31E 2.1 FT. CEDAR 4" N24W 9.5 FT. CEDAR 6" SOUTH 19.3 FT.	TWIN OAK 20" N63W 10.32 FT. TWIN OAK 20" S11W 34.79 FT. OAK 5" S72E 8.20 FT.

Signed by \_\_\_\_\_

*Carl Johnson*

Date \_\_\_\_\_

3/17/92

Surveyor's Michigan License No. \_\_\_\_\_

30083