LAND CORNER RECORDATION CERTIFICATE

Filing Requirement of Act 74, Mich. P.A. 1970

For corners in ROSCOMMON (County)

	Located In:	Corner Code ##
1. Public Land Survey	T 23N R 3W	L-5
	T ___ R ___	
	T ___ R ___	
	T ___ R ___	
2. Property Controlling	S 13 T ___ R ___	1, 2, 9
in Section	S ___ T ___ R ___	
3. Miscellaneous	S ___ T ___ R ___	
Property in Sec.	S ___ T ___ R ___	

Register of Deeds Stamp & File Number

4. Lot No. _____ , Recorded Plat _____
5. Private Claims _____

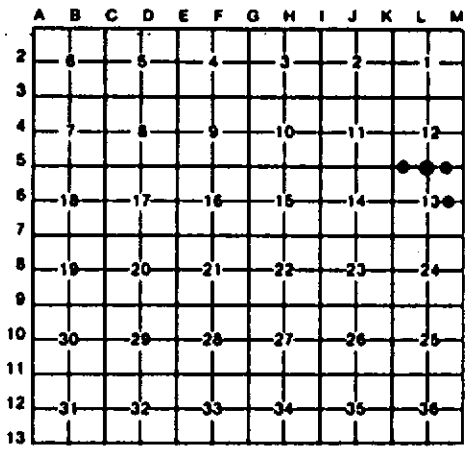

I, CARL F. ROSER, in a field survey on SEPTEMBER 9, 19 91, do hereby certify that under requirements of P.A. 74, Michigan P.A. of 1970, the corner points mentioned in lines 1 and 2 above were in conformance with regulations and rules therefore as required in the current manual of survey instructions of the United States Department of the Interior, Bureau of Land Management or by a decree of a Court of Law and/or that the corner points mentioned in lines 3, 4 and 5 above were in conformance with the rules of the Michigan Board of Land Surveyors or by a Decree of a Court of Law; established, re-established, monumented, re-monumented, recovered, found as expressed below:

NOTE: Not more than 4 corners, all in the same town and range, may be recorded on this certificate.

A. Description of original monument and accessories and/or subsequent restoration:

L-5 1 2 9

(NO EVIDENCE OF G.L.O. CORNER, B.T'S, LINE TREES & TOPOGRAPHY, AS CALLED OUT IN THE G.L.O. LINE NOTES; UNLESS NOTED IN ITEM "B" BELOW.)

NOTE: Above land corner's were recovered or set, and field corner records completed, during a survey in this area by D.N.R. Land Surveyor, Carl R. Johnson, L.S. #30083 (Now Retired). They are being recorded per Act 74, PA 1970, by Dept. Surveyor, C.F. Roser.

STATE OF MICHIGAN
CARL F. ROSER
LAND SURVEYOR
No. 12028
REGISTERED LAND SURVEYOR

B. Description of corner evidence found and/or method applied in restoring or reestablishing corner:

L-5	1	2	9
SET MIDWAY AND ON LINE BETWEEN SECTION CORNERS.	SET BY STANDARD SURVEY PROCEDURE FOR SUBDIVISION OF A SECTION.	SET BY STANDARD SURVEY PROCEDURE FOR SUBDIVISION OF A SECTION.	SET BY STANDARD SURVEY PROCEDURE FOR SUBDIVISION OF A SECTION.

C. Description of monument for corner and accessories established to perpetuate locating the position of the corner:

L-5	1	2	9
BNR MON & CED POST.	5/8 REROD W/CAP & CED POST.	SET 5/8" REROD W/CAP & CEDAR POST.	5/8" REROD W/CAP & CEDAR POST.
CHERRY 6" S01°E 15.85'	ASPEN 10" S07°W 30.5'	W PINE 8" S41°E 55.9'	OAK 8" N30°E 23.4'
OAK 4" S84°W 38.92'	MAPLE 10" S50°W 28.8'	W PINE 6" S09°W 16.3'	OAK 10" N68°W 28.6'
CHERRY 4" N68°W 34.35'	MAPLE 10" N02°W 31.2'	CHERRY 8" N52°W 38.4'	OAK 12" S27°W 17.5'
CHERRY 6" N10°E 53.20'		OAK 36" N08°E 50.0'	OAK 8" S15°E 35.0'
	UPPER & LOWER BLAZES W/SCRIBES	NAIL & TAG.	
UPPER & LOWER BLAZES W/SCRIBES		PIPE 1" N12°E 11.6'	LOWER BLAZES & SCRIBES.
		UPPER & LOWER BLAZES W/SCRIBES	

Signed by Carl F. Roser 5-04-94 Date _____

Surveyor's Michigan License No. 12028

FORM APPROVED BY MICHIGAN STATE BOARD OF LAND SURVEYORS, JAN. 25, 1971
REVISED MAY 14, 1975
REVISED JAN., 1983