LAND CORNER RECORDATION CERTIFICATE

Filing Requirement of Act 74, Mich. P.A. 1970

For corners in ROSCOMMON (County)

	Located In:	Corner Code ##
1. Public Land Survey	T 23N R 3W	M-7; M-8;
	T ___ R ___	M-9; M-10
	T ___ R ___	
	T ___ R ___	
2. Property Controlling	S ___ T ___ R ___	
in Section	S ___ T ___ R ___	
3. Miscellaneous	S ___ T ___ R ___	
Property in Sec.	S ___ T ___ R ___	

Register of Deeds Stamp & File Number

4. Lot No. _____ , Recorded Plat _____
5. Private Claims _____

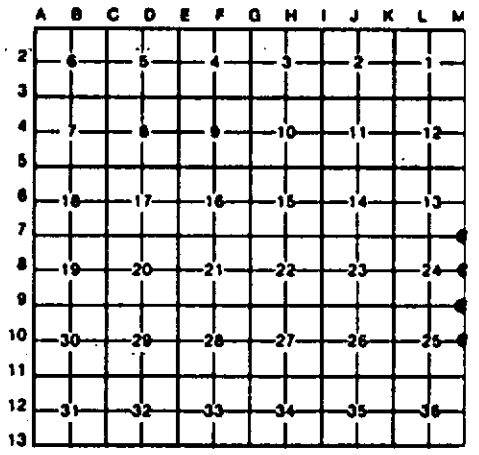

I, CARL F. ROSER, in a field survey on JUNE 26, 19 91, do hereby certify that under requirements of P.A. 74, Michigan P.A. of 1970, the corner points mentioned in lines 1 and 2 above were in conformance with regulations and rules therefore as required in the current manual of survey instructions of the United States Department of the Interior, Bureau of Land Management or by a decree of a Court of Law and/or that the corner points mentioned in lines 3, 4 and 5 above were in conformance with the rules of the Michigan Board of Land Surveyors or by a Decree of a Court of Law; established, re-established, monumented, re-monumented, recovered, found as expressed below:

NOTE: Not more than 4 corners, all in the same town and range, may be recorded on this certificate.

A. Description of original monument and accessories and/or subsequent restoration:

M-7 M-8 M-9 M-10

(NO EVIDENCE OF G.L.O. CORNER, B.T'S, LINE TREES & TOPOGRAPHY, AS CALLED OUT IN THE G.L.O. LINE NOTES; UNLESS NOTED IN ITEM "B" BELOW.)

STATE OF MICHIGAN — CARL F. ROSER — LAND SURVEYOR — No. 12028 — REGISTERED LAND SURVEYOR

NOTE: Above land corner's were recovered or set, and field corner records completed, during a survey in this area by D.N.R. Land Surveyor, Carl R. Johnson, L.S. #30083 (Now Retired). They are being recorded per Act 74, PA 1970, by Dept. Surveyor, C.F. Roser.

B. Description of corner evidence found and/or method applied in restoring or reestablishing corner:

M-7	M-8	M-9	M-10
FD AND ACCEPTED THIS SURVEY. FD WITNESSES FROM HENNING SURVEY 1955.	FOUND AND ACCEPTED THIS SURVEY. FD WITNESSES FROM HENNING SURVEY 1955.	FOUND AND ACCEPTED THIS SURVEY. FD WITNESSES FROM HENNING SURVEY 1955.	FD AND ACCEPTED THIS SURVEY. FD WITNESSES FROM HENNING SURVEY 1955.

C. Description of monument for corner and accessories established to perpetuate locating the position of the corner:

M-7			M-8			M-9			M-10		
FD RAILROAD SPIKE.			1 1/4" PIPE RAISED WITH 5/8" BAR.			FD 1/2" BAR.			FD 1/2" BAR.		
6" PINE	S56°E	70.75'				24" CEDAR	N24°W	87.75'	12" WH PINE	N50°W	42.20'
6" TAMARACK	N54°E	86.30'	8" RED OAK	N78°W	38.69'	10" RED OAK	N80°E	55.33'	14" WH PINE	S36°W	69.66'
10" PINE	S89°W	84.45'	6" RED OAK	S82°W	44.97'	8" RED OAK	S74°E	50.30'	8" WH PINE	S64°E	51.50'
6" CEDAR	S54°W	81.75'	8" IRONWOOD	N72°E	51.68'				8" WH PINE	N80°E	50.50'
			10" MAPLE	S27°E	83.10'	NAIL W/REF. TAGS.					
NAIL W/REF. TAGS.			NAIL W/REF. TAGS.						NAIL W/REF. TAGS.		
			1 1/4" PIPE	S72°W	33.55'						

Signed by Carl F. Roser 5-04-94 Date _____

Surveyor's Michigan License No. 12028

FORM APPROVED BY MICHIGAN STATE BOARD OF LAND SURVEYORS, JAN. 20, 1971
REVISED MAY 14, 1975
REVISED JAN., 1983