

**SURVEY &
REMONUMENTATION**

9691

MAY 28 1997

**LAND CORNER RECORDATION CERTIFICATE
Filing Requirement of Act 74, Michigan P.A. 1970**

STATE OF MICHIGAN
ROSCOMMON COUNTY
RECORDED

For corners in

ROSCOMMON
(County)

Located In:

Corner Code #

- | | | | | | |
|------------------------------------|---|------|---|-----|---------|
| 1. Public Land Survey | T | 24 N | R | 3 W | C-13 |
| | T | 23 N | R | 3 W | (C-1) ✓ |
| | T | | R | | |
| | T | | R | | |
| 2. Property Controlling in Section | S | | T | R | |
| | S | | T | R | |
| 3. Miscellaneous Property in Sec. | S | | T | R | |
| | S | | T | R | |

27 DEC 96 2:17 P.M.

ROBERT W. SMITH
REGISTER OF DEEDS

Register of Deeds Stamp & File Number

4. Lot No. _____, Recorded Plat _____
5. Private Claims _____

	A	B	C	D	E	F	G	H	I	J	K	L	M
2	6	5	4	3	2	1							
3													
4	7	8	9	10	11	12							
5													
6	18	17	16	15	14	13							
7													
8	19	20	21	22	23	24							
9													
10	30	29	28	27	26	25							
11													
12	31	32	33	34	35	36							
13													

I, Frank J. Arleth, in a field survey on November 6, 1996, do hereby certify that under requirements of P.A. 74, Michigan P.A. of 1970, the corner points mentioned in lines 1 and 2 above were in conformance with regulations and rules therefore as required in the current manual of survey instructions of the United States Department of the Interior, Bureau of Land Management or by a decree of a Court of Law and/or that the corner points mentioned in lines 3, 4 and 5 above were in conformance with the rules of the Michigan Board of Land Surveyors or by a Decree of a Court of Law; established, re-established, monumented, re-monumented, recovered, found as expressed below:

NOTE: Not more than 4 corners, all in the same town and range, may be recorded on this certificate.

A. Description of original monument and accessories and/or subsequent restoration:

WILLIAM BURT 1852
W. PINE 18" N22½°E, 39 LKS.
Y. PINE 12" N46°W, 35 LKS.
Y. PINE 16" S45°W, 42 LKS.
W. PINE 30" S70°E, 22 LKS.

DELAMATER 1924 FOUND BTS. & Post
WIT. 18" W. PINE STP. N22°E, 25.70'
WIT. 24" W. PINE STP. S70°E, 31.30'
WIT. 30" W. PINE STP. S40°E, 19.80'
WIT. 24" W. PINE STP. S68°W, 22.40'

HENNING 1947 FOUND AND USED BTS. OK.
IRON IN CORNER

HENNING 1955 IN ROAD SURVEY
FOUND 1/2" BAR IN CORNER
MKD. 8" B. OAK S53°E, 74.5'
MKD. 10" B. OAK S58½°W, 80.5'
MKD. 10" W. OAK N18°E, 76.20'

ROSCOMMON Co. Rd. COMM.
FOUND IN PAV'T. BOX
CENTERLINE OF Co. Rd. 104
PLAT OF HIGGINS LAKE
HIGHLANDS L- 5, P-77

B. Description of corner evidence found and/or method applied in restoring or reestablishing corner:

FOUND 1/2" BAR IN PAV'T. BOX CENTERLINE OF Co. Rd. #104 AND ROADS N&S.
FOUND OLD WIT. 8" B. OAK S53°E, 74.50'
FOUND OLD WIT. 10" S58½°W, 80.50'

ROSCOMMON COUNTY

PEER GROUP APPROVAL


DATE Nov 8th 1996

Marvin E. Myers M.E.S.

**Marvin E. Myers, P.S.
County Surveyor**

C. Description of monument for corner and accessories established to perpetuate locating the position of the corner:

1/2" BAR IN PAV'T. BOX WITH CAP # 21266 IN CENTERLINE OF Co. Rd. #104 AND ROADS N&S.
N & T POWER POLE N46°E, 41.05'
N & T 16" W. PINE S50°W, 94.95'
N & T 5" MAPLE N46°W, 72.45'
N & T B. OAK S46°W, 60.78'
SET CARSONITE POST N45 E, 45.95'

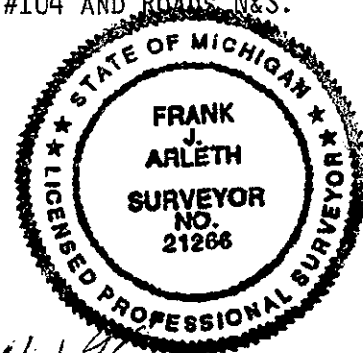

Signed by Frank J. Arleth Date 8 Nov 96

Surveyor's Michigan License No. 21266, P.S.

DATE: 8 Nov 96 **PEER GROUP APPROVAL:**

LIBER 3 PAGE 390