

**SURVEY &
REMONUMENTATION**

8600

APR 24 1995

LAND CORNER RECORDATION CERTIFICATE

COMMISSION Filing Requirement of Act 74, Mich. P.A. 1970

STATE OF MICHIGAN
ROSCOMMON COUNTY
RECORDED

For corners in

ROSCOMMON (County)	Located In:	Corner Code #
1. Public Land Survey	T 23N, R3W	D-7
	T _____ R _____	_____
	T _____ R _____	_____
	T _____ R _____	_____
2. Property Controlling in Section	S _____ T _____ R _____	_____
	S _____ T _____ R _____	_____
3. Miscellaneous Property in Sec.	S _____ T _____ R _____	_____
	S _____ T _____ R _____	_____

22 NOV 94 11:08 A.M.

ROBERT W. SMITH
REGISTER OF DEEDS
ROSCOMMON COUNTY
PEER GROUP APPROVAL
DATE 10-20-94

Register of Deeds Stamp & File Number

1. Lot No. _____, Recorded Plat _____
2. Private Claims _____

	A	B	C	D	E	F	G	H	I	J	K	L	M
2	6	5	4	3	2	1							
3													
4	7	8	9	10	11	12							
5													
6	16	17	16	15	14	13							
7													
8	19	20	21	22	23	24							
9													
10	30	29	28	27	26	25							
11													
12	31	32	33	34	35	36							
13													

Marvin E. Myers in a field survey on October 13, 19 94


do hereby certify that under requirements of P.A. 74, Michigan P.A. of 1970, the corner points mentioned in lines 1 and 2 above were in conformance with regulations and rules therefore as required in the current manual of survey instructions of the United States Department of the Interior, Bureau of Land Management or by a decree of a Court of Law and/or that the corner points mentioned in lines 3, 4 and 5 above were in conformance with the rules of the Michigan Board of Land Surveyors or by a Decree of a Court of Law; established, re-established, monumented, re-monumented, recovered, found as expressed below:

NOTE: Not more than 4 corners, all in the same town and range, may be recorded on this certificate.

1. Description of original monument and accessories and/or subsequent restoration:
- | | | |
|---|--|---|
| GLO- Artmas Curtis 1852
Mon- Set Post
Wit- 12" Tamarack N15°E 1ks
8" Cedar S60°W 35 lks | L2 P 376 LCRC
Mon- Mon. box in center
of County Road #100
Wit- None given | April 18, 1988 L 1 P.247 LCRC L. Cavanagh
Mon- ½" bar in Pav't Box
Wit- P.Pole S75°W 32.5
Spike in NW side 9" cedar N50°E 47.0
Spike in NE side 10" Maple N37°W 87.0
½" Steel Bar East on Section line 33.00 |
| 1928 G.F. Delamater
Mon- Set ½" bar in road
Wit- 7" Cedar N53°E 44.7
6" Cedar S84°W 33.6
May 1962 R.T. Ostling
Mon- ½" bar
Wit- Same as Delamater(1928) | May 30, 1978 L. Cavanagh
Mon- ½" bar in Pav't
Wit- ½" bar East 33.00
PP. S75°W 32.50
E. Edge of sign post
N20°W 62.10 | |

2. Description of corner evidence found and/or method applied in restoring or reestablishing corner:
- Found ½"x24" bar over 2" ID pipe in Mon Box 4.1 feet East of Center line of Flint Road.
 - Found the follow accessories ½" bar and cap #17614 S84°E 32.98
 - Found spike in S Side of UP S80°W 32.70
 - Found spike NW side 10" Cedar N54°E 46.99
 - Found 12" Dead Cedar marked "NBT" N56°E 44.62
- Accepted as the best available evidence of the position of the original corner.

3. Description of monument for corner and accessories established to perpetuate locating the position of the corner:
- Set Std. Roscommon County Monument stamped " T23N, R3W, 31600, D-7" over top of 2" ID pipe.
 - Set Roscommon County witness tag & nail N. side 9" Maple clump S53°E 43.59
 - E. Edge of Easterly sign post N05°W 141.19
 - Found ½" bar #17614 S84°E 32.98
 - Found spike S. side Utility Pole S80°W 32.70
 - Found Spike NW side 10" Cedar N54°E 46.99
 - Set carsonite post S82°E 33±

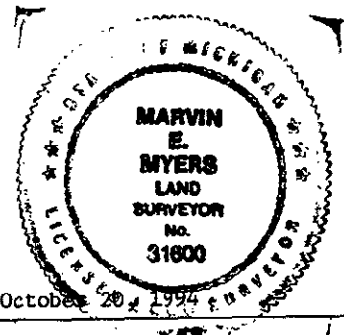

Signed by Marvin E. Myers Date October 20, 1994
Surveyor's Michigan License No. 31600