

LAND CORNER RECORDATION CERTIFICATE
Filing Requirement of Act 74, Mich. P.A. 1970

STATE OF MICHIGAN
 ROSCOMMON COUNTY
 RECORDED

For corners in

<u>ROSCOMMON</u> (County)	Located In:	Corner Code #
1. Public Land Survey	T23N R 3W	E-7
	T _____ R _____	_____
	T _____ R _____	_____
	T _____ R _____	_____
2. Property Controlling in Section	S _____ T _____ R _____	<i>Sec. #1 pm</i>
	S _____ T _____ R _____	_____
3. Miscellaneous Property in Sec.	S _____ T _____ R _____	_____
	S _____ T _____ R _____	_____

22 NOV 94 11:10 A.M.

ROBERT W. SMITH
 REGISTER OF DEEDS
ROSCOMMON COUNTY
PEER GROUP APPROVAL
 DATE 10-20-94 *MEM*

Register of Deeds Stamp & File Number

4. Lot No. _____, Recorded Plat _____
 5. Private Claims _____

Marvin E. Myers, in a field survey on October 14, 19 94
do hereby certify that under requirements of P.A. 74, Michigan P.A. of 1970, the corner points mentioned
in lines 1 and 2 above were in conformance with regulations and rules therefore as required in the
current manual of survey instructions of the United States Department of the Interior, Bureau of Land
Management or by a decree of a Court of Law and/or that the corner points mentioned in lines 3, 4 and 5
above were in conformance with the rules of the Michigan Board of Land Surveyors or by a Decree of a
Court of Law; established, re-established, monumented, re-monumented, recovered, found as
expressed below:

**NOTE: Not more than 4 corners, all in the same town and range, may be recorded
on this certificate.**

A	B	C	D	E	F	G	H	I	J	K	L	M
2	6	5	4	3	2	1						
3												
4	7	8	9	10	11	12						
5												
6	18	17	16	15	14	13						
7												
8	19	20	21	22	23	24						
9												
10	30	29	28	27	26	25						
11												
12	31	32	33	34	35	36						
13												

1. Description of original monument and accessories and/or subsequent restoration:

GLO- Artemas Curtis 1852
 MON- Set Post
 Wit 10" Tamarack N50°E 43 lks
 14" Tamarack S80°W 34 lks

UNKNOWN SURVEYOR
 Mon- ½" bar and Post
 Wit- None given


3. Description of corner evidence found and/or method applied in restoring or reestablishing corner:

Found ½"x30" bar. Found blaze & wit tag marked "G.F. Delamater Surveyor Gaylord, Michigan, 1928" in East face of
 11" Cedar N79°W 21.97

Accepted as the best available evidence of the position of the original corner.

2. Description of monument for corner and accessories established to perpetuate locating the position of the corner:

Mon- Set Std. Roscommon County Monument stamped "T23N, R3W, 31600, E-7"
 Wit- Set Roscommon County witness tag & nail SW side 15" Maple N15°W 21.38
 Wit- Set Roscommon County witness tag & nail NW side 5" Cedar S68°E 13.51
 Wit- Set Roscommon County witness tag & nail NW side 7" Cedar S34°W 17.38
 Wit- Set Roscommon County witness tag & nail S. side 6" Cedar N70°W 17.34
 Set carsonite post S06°W 3.0

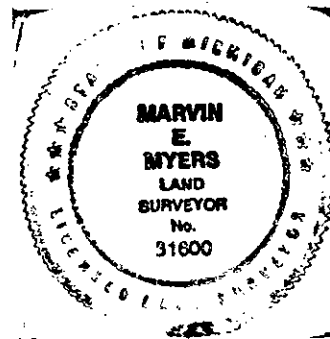

Signed by Marvin E. Myers

Date October 20, 1994

Surveyor's Michigan License No. 31600

FORM APPROVED BY MICHIGAN STATE BOARD OF LAND SURVEYORS, JAN. 28, 1971
 REVISED MAY 14, 1975
 REVISED JAN., 1983

LIBER 3 PAGE 180