

**SURVEY &  
REMONUMENTATION**

APR 24 1995

**ROSCOMMON COUNTY**

**PEER GROUP APPROVAL COMMISSION**

**DATE** Dec 13, 1994

ROSCOMMON COUNTY REMONUMENTATION  
**LAND CORNER RECORDATION CERTIFICATE**  
Filing Requirement of Act 74, Mich. P.A. 1970

STATE OF MICHIGAN  
ROSCOMMON COUNTY  
RECORDED

9190

For corners in

Roscommon (County)	Located In:	Corner Code #
1. Public Land Survey	T 23N R 3W	E - 7
	T _____ R _____	_____
	T _____ R _____	_____
	T _____ R _____	_____
2. Property Controlling in Section	S _____ T _____ R _____	_____
	S _____ T _____ R _____	_____
3. Miscellaneous Property in Sec.	S _____ T _____ R _____	_____
	S _____ T _____ R _____	_____
4. Lot No. _____, Recorded Plat _____		
5. Private Claims _____		

16 DEC 94 2:35 P.M.

ROBERT W. SMITH  
REGISTER OF DEEDS

TO BE FILED IN LIBER 3 OF LAND CORNER  
Register of Deeds Stamp & File Number

I, Marvin E. Myers, in a field survey on October 13, 19 94, do hereby certify that under requirements of P.A. 74, Michigan P.A. of 1970, the corner points mentioned in lines 1 and 2 above were in conformance with regulations and rules therefore as required in the current manual of survey instructions of the United States Department of the Interior, Bureau of Land Management or by a decree of a Court of Law and/or that the corner points mentioned in lines 3, 4 and 5 above were in conformance with the rules of the Michigan Board of Land Surveyors or by a Decree of a Court of Law; established, re-established, monumented, re-monumented, recovered, found as expressed below:

**NOTE: Not more than 4 corners, all in the same town and range, may be recorded on this certificate.**

	A	B	C	D	E	F	G	H	I	J	K	L	M
2	6	5	4	3	2	1							
3													
4	7	8	9	10	11	12							
5													
6	18	17	16	15	14	13							
7													
8	19	20	21	22	23	24							
9													
10	30	29	28	27	26	25							
11													
12	31	32	33	34	35	36							
13													

**A. Description of original monument and accessories and/or subsequent restoration:**

GLO-Artemas Curtis 1852  
Mon-Set Post  
WIT: 10" Tamarack N50°E 43 lks.  
14" Tamarack S80°W 34 lks.


Unknown Surveyor  
Mon-½" Bar & Post  
WIT: None

**B. Description of corner evidence found and/or method applied in restoring or reestablishing corner:**

Monument - Found ½" x 30" Bar  
WIT: Found blaze and wit. tag marked "G.F. Delamater surveyor Gaylord, Mich. 1928" East face 11" Cedar N79°W 21.97'  
Accepted as a best available evidence of the position of the original corner.

**C. Description of monument for corner and accessories established to perpetuate locating the position of the corner:**

Mon-Set Std. Roscommon County Mon. stamped "T23N R3W E-7 31600"  
WIT: Fd. blaze & wit. tag mkd. "G.F. Delamater surveyor Gaylord, Mich. 1928" E. face 11" Cedar N79°W 21.97'  
Set wit. tag & nail SW side 15" Maple N15°W 21.38'  
Set wit. tag & nail N. side 5" Cedar S68°E 13.51'  
Set wit. tag & nail NW side 7" Cedar S34°W 17.38'  
Set wit. tag & nail S. side 6" Cedar N70°W 17.34'  
Set carsonite post S06°W 3.0'

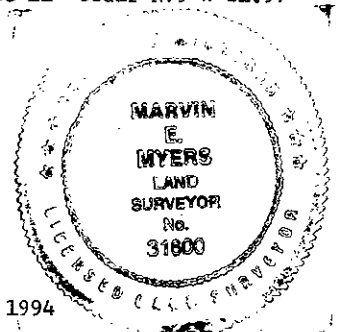

Signed by Marvin E. Myers  
Surveyor's Michigan License No. 31600

Date Dec 15, 1994

LIBER 3 PAGE 102