

8598

SURVEY REMONUMENTATION

ROSCOMMON COUNTY

PEER GROUP APPROVAL

APR 24 1995

DATE 10-20-94

LAND CORNER RECORDATION CERTIFICATE Filing Requirement of Act 74, Mich. P.A. 1970

STATE OF MICHIGAN ROSCOMMON COUNTY RECORDED

For corners in


Table with columns: Roscommon (County), Located In, Corner Code. Rows include Public Land Survey, Property Controlling in Section, and Miscellaneous Property in Sec.

22 NOV 94 11:08 A.M.

ROBERT W. SMITH REGISTER OF DEEDS

Register of Deeds Stamp & File Number

4. Lot No. Recorded Plat
5. Private Claims

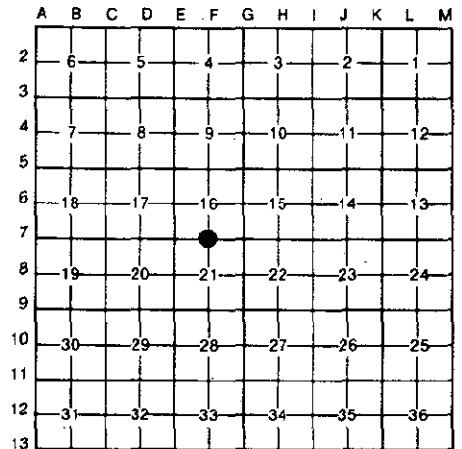

I, Marvin E. Myers, in a field survey on October 18, 1994

do hereby certify that under requirements of P.A. 74, Michigan P.A. of 1970, the corner points mentioned in lines 1 and 2 above were in conformance with regulations and rules therefore as required in the current manual of survey instructions of the United States Department of the Interior, Bureau of Land Management or by a decree of a Court of Law and/or that the corner points mentioned in lines 3, 4 and 5 above were in conformance with the rules of the Michigan Board of Land Surveyors or by a Decree of a Court of Law; established, re-established, monumented, re-monumented, recovered, found as expressed below:

NOTE: Not more than 4 corners, all in the same town and range, may be recorded on this certificate.

A. Description of original monument and accessories and/or subsequent restoration:

- List of survey descriptions including: GLO-Artemas Curtis 1852, Robert Ostling 6-53, L.2, pg.375 LCRC, L.2, pg.380 LCRC, Larry Cavanagh L.1, pg.135 LCRC 2-77, Larry Cavanagh L.331, pg.445 2-17-1977, Larry Cavanagh L.331, pg.442 4-27-77, Larry Cavanagh L.338, pg.565 10-19-77.


B. Description of corner evidence found and/or method applied in restoring or reestablishing corner:

Monument found 5/8" x 16" Bar in monument box 5.70 feet East of centerline of Markey Road (County Road 100). Found the following accessories: Roscommon County reference Tag & Nail SW side 8" Cedar N36°W 63.35' Blaze E. face 8" Cedar N73 1/2°W 42.57' (to blaze)

Accepted as the best available evidence of the position of the original corner.

C. Description of monument for corner and accessories established to perpetuate locating the position of the corner:

Mon-Set Standard Roscommon County Monument stamped "T23N R3W F-7 31600" in mon. box 5.70' East WIT: Set Wit. Tag & Nail S. side 8" Cedar N73°W 42.67' Set Wit. Tag & Nail N. side 10" Elm S61°E 38.66' Set Wit. Tag & Nail SE side 9" Maple S33°W 81.57' Set Wit. Tag & Nail N. side 8" Balsam N82°E 40.12' Set Carsonite Post S87°E 34.4'±

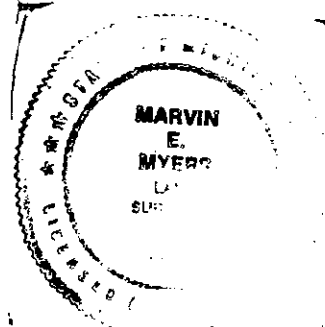

Signed by Marvin E. Myers

Date Nov 9, 1994

Surveyor's Michigan License No. 31600