

**SURVEY &
REMONUMENTATION**

**ROSCOMMON COUNTY
PEER GROUP APPROVAL**

APR 24 1995

DATE Dec 13, 1994

ROSCOMMON COUNTY REMONUMENTATION
LAND CORNER RECORDATION CERTIFICATE
Filing Requirement of Act 74, Mich. P.A. 1970

STATE OF MICHIGAN
ROSCOMMON COUNTY
RECORDED

9192

For corners in

<u>Roscommon</u> (County)	Located In:	Corner Code #
1. Public Land Survey	T 23N R 3W	F - 10
	T _____ R _____	_____
	T _____ R _____	_____
	T _____ R _____	_____
2. Property Controlling in Section	S _____ T _____ R _____	_____
	S _____ T _____ R _____	_____
3. Miscellaneous Property in Sec.	S _____ T _____ R _____	_____
	S _____ T _____ R _____	_____
4. Lot No. _____, Recorded Plat _____		
5. Private Claims _____		

16 DEC 94 2:36 P.M.

ROBERT W. SMITH
REGISTER OF DEEDS

TO BE FILED IN LIBER 3 OF LAND CORNER
Register of Deeds Stamp & File Number

I, Marvin E. Myers, in a field survey on October 13, 19 94, do hereby certify that under requirements of P.A. 74, Michigan P.A. of 1970, the corner points mentioned in lines 1 and 2 above were in conformance with regulations and rules therefore as required in the current manual of survey instructions of the United States Department of the Interior, Bureau of Land Management or by a decree of a Court of Law and/or that the corner points mentioned in lines 3, 4 and 5 above were in conformance with the rules of the Michigan Board of Land Surveyors or by a Decree of a Court of Law; established, re-established, monumented, re-monumented, recovered, found as expressed below:

A	B	C	D	E	F	G	H	I	J	K	L	M
2	6	5	4	3	2	1						
3												
4	7	8	9	10	11	12						
5												
6	18	17	16	15	14	13						
7												
8	19	20	21	22	23	24						
9												
10	30	29	28	27	26	25						
11												
12	31	32	33	34	35	36						
13												

NOTE: Not more than 4 corners, all in the same town and range, may be recorded on this certificate.

A. Description of original monument and accessories and/or subsequent restoration:


Ostling 1948 Mon-5/8" Bar in corner WIT: 10" Maple N42 1/2°E 50.20' 12" Elm S71 3/4°E 60.00'	Ostling 10-13-69 Mon- WIT: Fd. Pipe N89°10'W 33.00' Fd. Concrete Mon N00°40'E 200.00 on S. R/W of Dale Road	R. Ostling Jan 1947 Mon- Unknown Wit- N00°49'E 2649.2 to F-9
Ostling 11-51 Mon-5/8" Bar in corner WIT: 10" Maple N42 1/2°E 50.20' 12" Elm S71 3/4°E 60.00'		

B. Description of corner evidence found and/or method applied in restoring or reestablishing corner:

Found concrete monument for corner verified position by measurement to concrete monument 200 feet North on the South Right of Way of Dale Road.
Accepted as the best available evidence of the position of the original corner.

C. Description of monument for corner and accessories established to perpetuate locating the position of the corner:

Mon-Set Standard Roscommon County Monument stamped "T23N R3W F-10 31600"
WIT: Set Wit. Tag & Nail SW side 13" R.Oak N12°W 17.85'
Set Wit. Tag & Nail SW side U.P. N41°W 45.21'
Set Wit. Tag & Nail S. side 8" Elm clump N85°E 14.39'
Set Wit. Tag & Nail SW side 7" Maple S27°E 18.96'
Set Carsonite Post S03°W 2.20'
S89°50'19"E 2657.56 to G-10
N00°09'07"E 2648.91 to F-9

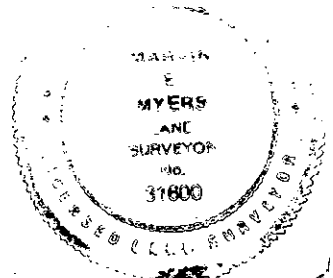

Signed by Marvin E. Myers

Date DEC 15, 1994

Surveyor's Michigan License No. 31600