

92477 18 1993
COMMISSIONER

ROSCOMMON COUNTY REMONUMENTATION

STATE OF MICHIGAN
COUNTY OF ROSCOMMON

Dec 28 10 28 AM '93

LAND CORNER RECORDATION CERTIFICATE
Filing Requirement of Act 74, Mich. P.A. 1970

For corners in

Roscommon (County)	Located In:	Corner Code #
1. Public Land Survey	T 23N R 3W	G - 4
	T R	
	T R	
	T R	
2. Property Controlling in Section	S T R	
	S T R	
3. Miscellaneous Property in Sec.	S T R	
	S T R	
4. Lot No. _____, Recorded Plat _____		
5. Private Claims _____		

Robert A. ...
REGISTER OF DEEDS

ROSCOMMON COUNTY
PEER GROUP APPROVAL
DATE 12-7-93

Register of Deeds Stamp & File Number

I, Marvin E. Myers, in a field survey on Nov 29, 19 93, do hereby certify that under requirements of P.A. 74, Michigan P.A. of 1970, the corner points mentioned in lines 1 and 2 above were in conformance with regulations and rules therefore as required in the current manual of survey instructions of the United States Department of the Interior, Bureau of Land Management or by a decree of a Court of Law and/or that the corner points mentioned in lines 3, 4 and 5 above were in conformance with the rules of the Michigan Board of Land Surveyors or by a Decree of a Court of Law; established, re-established, monumented, re-monumented, recovered, found as expressed below:

	A	B	C	D	E	F	G	H	I	J	K	L	M
2	6	5	4	3	2	1							
3													
4	7	8	9	10	11	12							
5													
6	18	17	16	15	14	13							
7													
8	19	20	21	22	23	24							
9													
10	30	29	28	27	26	25							
11													
12	31	32	33	34	35	36							
13													

NOTE: Not more than 4 corners, all in the same town and range, may be recorded on this certificate.


A. Description of original monument and accessories and/or subsequent restoration:

- GLO - May 1852 A.Curtis
Mon. - Post
WIT: 24" W.Pine N83°E 7 lks.
30" W.Pine S56°W 3 lks.
- Aug. 1957 R.Ostling
Mon. - 1/2"x24" Bar
WIT: 5" Maple S9 1/2°W 36.10'
24" R.Oak S78°W 66.15'
- Nov. 1969 G.Henning
Mon. - 1/2" Bar
WIT: 1/2" Bar & Stake N89°17'E 33.0'
24" W.Oak S77°W 66.10'
16" Maple N17°E 69.60'
1/2" Bar N89°44'W 33.0' (1957)
- L.2, pg. 368 Reg. of Deeds
Mon. - 1/2" Bar
WIT: 5" Maple S9 1/2°W 36.10'
24" R.Oak S78°W 66.15'
- L. 357, pg. 228 Nov. 1978 K.Ostling
Mon. - Fd. 1/2"x24" Bar
WIT: 5" Maple S9 1/2°W 36.10'
24" R.Oak S78°W 66.15'
- May 1989 M.E.Myers
Mon. - Fd. 1/2" Bar W. edge Rd.
WIT: Spike in W. face 4" Maple
Clump S15°W 36.60'
Spike in N. face 4" Maple
Clump N85°W 21.70'
Spike NE face 3" Maple
N22°W 37.55'
Spike in NW face 12" B. Oak
N20°E 32.10'
- Oct. 1990 L.Cavanagh
Mon. - fd. 1/2" Bar
WIT: 6" Maple N85°W 20.10'
15" Oak N15°E 31.55'
12" Maple S10°W 35.85'
3" Poplar S40°E 34.30'
- L.631, pg. 283 M.E.Myers
Mon. - 1/2" Bar
WIT: 6" Maple N85°W 20.10'
15" Oak N15°E 31.55'
12" Maple S10°W 35.85'
3" Poplar S40°E 34.30'

B. Description of corner evidence found and/or method applied in restoring or reestablishing corner.
Found 1/2" bar verified position by measurement to accessories of record and accepted as the best available evidence of the position of the original corner.

C. Description of monument for corner and accessories established to perpetuate locating the position of the corner:

- Mon- Replaced 1/2" x24" bar with Std. Roscommon County Monument. Corner is in West track of N-S Trail Road.
- Wit-Found nail N. side 6" Maple N85°W 21.70'
- Found Nail W. side 5" Maple clump S15°W 36.53'
- Set Std. Roscommon County Nail & Tag in NE side 3" Poplar S40°E 34.44'
- Found Nail NW side 12" B. Oak N20°E 32.04'
- Found blazed 15" Oak N15°E 31.55'
- Found blazed 12" Maple S10°W 35.85'
- Found blazed 3" poplar S40°E 34.3'
- Found blazed 6" Maple N85°W 20.1'

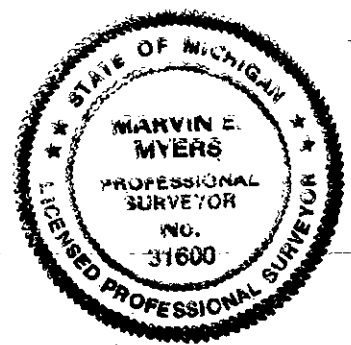

Signed by Marvin E. Myers Date Dec 18, 1993
Surveyor's Michigan License No. 31600

FORM APPROVED BY MICHIGAN STATE BOARD OF LAND SURVEYORS, JAN. 26, 1971
REVISED MAY 14, 1976
REVISED JAN., 1983

DATE Dec 7, 1993 PEER GROUP APPROVAL