

**SURVEY
REMONUMENTATION**

**ROSCOMMON COUNTY
PEER GROUP APPROVAL
DATE _____**

APR 24 1995

LAND CORNER RECORDATION CERTIFICATE
Filing Requirement of Act 74, Mich. P.A. 1970

STATE OF MICHIGAN
ROSCOMMON COUNTY
RECORDED

For corners in

| | | |
|---------------------------------------|--------------------------|----------------|
| <u>Roscommon</u> (County) | Located In: | Corner Code #/ |
| 1. Public Land Survey | T <u>23N</u> R <u>3W</u> | <u>G - 10</u> |
| | T _____ R _____ | _____ |
| | T _____ R _____ | _____ |
| | T _____ R _____ | _____ |
| 2. Property Controlling in Section | S _____ T _____ R _____ | _____ |
| | S _____ T _____ R _____ | _____ |
| 3. Miscellaneous Property in Sec. | S _____ T _____ R _____ | _____ |
| | S _____ T _____ R _____ | _____ |
| 4. Lot No. _____, Recorded Plat _____ | | |
| 5. Private Claims _____ | | |

22 NOV 94 11:10 A.M.

ROBERT W. SMITH
REGISTER OF DEEDS

**ROSCOMMON COUNTY
PEER GROUP APPROVAL**
DATE 10-20-94

Register of Deeds Stamp & File Number

I, Marvin E. Myers, in a field survey on October 17, 1994, do hereby certify that under requirements of P.A. 74, Michigan P.A. of 1970, the corner points mentioned in lines 1 and 2 above were in conformance with regulations and rules therefore as required in the current manual of survey instructions of the United States Department of the Interior, Bureau of Land Management or by a decree of a Court of Law and/or that the corner points mentioned in lines 3, 4 and 5 above were in conformance with the rules of the Michigan Board of Land Surveyors or by a Decree of a Court of Law; established, re-established, monumented, re-monumented, recovered, found as expressed below:

NOTE: Not more than 4 corners, all in the same town and range, may be recorded on this certificate.

| | | | | | | | | | | | | | |
|----|----|----|----|----|----|----|---|---|---|---|---|---|---|
| | A | B | C | D | E | F | G | H | I | J | K | L | M |
| 2 | 6 | 5 | 4 | 3 | 2 | 1 | | | | | | | |
| 3 | | | | | | | | | | | | | |
| 4 | 7 | 8 | 9 | 10 | 11 | 12 | | | | | | | |
| 5 | | | | | | | | | | | | | |
| 6 | 18 | 17 | 16 | 15 | 14 | 13 | | | | | | | |
| 7 | | | | | | | | | | | | | |
| 8 | 19 | 20 | 21 | 22 | 23 | 24 | | | | | | | |
| 9 | | | | | | | | | | | | | |
| 10 | 30 | 29 | 28 | 27 | 26 | 25 | | | | | | | |
| 11 | | | | | | | | | | | | | |
| 12 | 31 | 32 | 33 | 34 | 35 | 36 | | | | | | | |
| 13 | | | | | | | | | | | | | |

A. Description of original monument and accessories and/or subsequent restoration:

GLO-Artemas Curtis 1852
Mon-Set Post
WIT: 10" Tamarack N40°E 39 lks.
12" Tamarack S65°W 17 lks.


Windemere Estates
Aug. 20, 1969
Mon-Unknown
WIT: Not Given
July 10, 1980 Harold Oliver
Mon-Unknown
WIT: None Given

B. Description of corner evidence found and/or method applied in restoring or reestablishing corner:

No evidence of original corner or accessories or subsequent restoration was found. Set midway and on line between G-11 and G-9, as a careful and faithful establishment of the position of the corner.

C. Description of monument for corner and accessories established to perpetuate locating the position of the corner:

Mon-Set Standard Roscommon County Monument stamped "T23N R3W G-10 31600"
WIT: Set 1/2" x 18" Bar & Cap mkd. "MEM 31600" with lath mkd. "Wit. Bar to G-10" along side S86°57'14"W 8.28'
Set 1/2" x 18" Bar & Cap mkd. "MEM 31600" N03°42'29"W 8.18'
Set 1/2" x 18" Bar & Cap mkd. "MEM 31600" N86°13'07"E 9.55'
Set 1/2" x 18" Bar & Cap mkd. "MEM 31600" S04°23'24"E 8.38'
Set Carsonite Post S09°05'39"W 2.84'
N00°30'14"E 2631.84' to G-9
S00°30'14"W 2631.84' to G-11

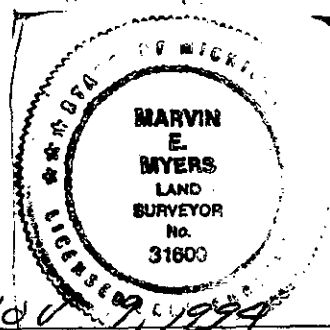

Signed by Marvin E. Myers

Date Nov 19 1994

Surveyor's Michigan License No. 31600

FORM APPROVED BY MICHIGAN STATE BOARD OF LAND SURVEYORS, JAN. 28, 1971
REVISED MAY 14, 1975
REVISED JAN., 1983