

**SURVEY &
REMONUMENTATION**

**ROSCOMMON COUNTY
PEER GROUP APPROVAL
DATE _____**

APR 24 1995
LAND CORNER RECORDATION CERTIFICATE
Filing Requirement of Act 74, Mich. P.A. 1970

STATE OF MICHIGAN
ROSCOMMON COUNTY
RECORDED

For corners in

ROSCOMMON (County)	Located In:	Corner Code #
1. Public Land Survey	T 23N R 3W	G-12
	T _____ R _____	_____
	T _____ R _____	_____
	T _____ R _____	_____
2. Property Controlling in Section	S _____ T _____ R _____	_____
	S _____ T _____ R _____	_____
3. Miscellaneous Property in Sec.	S _____ T _____ R _____	_____
	S _____ T _____ R _____	_____
4. Lot No. _____, Recorded Plat _____		
5. Private Claims _____		

22 NOV 94 11:08 A.M.

ROBERT W. SMITH
REGISTER OF DEEDS
**ROSCOMMON COUNTY
PEER GROUP APPROVAL
DATE 10-20-94** MEM

Register of Deeds Stamp & File Number

I, Marvin E. Myers, in a field survey on October 17, 19 94, do hereby certify that under requirements of P.A. 74, Michigan P.A. of 1970, the corner points mentioned in lines 1 and 2 above were in conformance with regulations and rules therefore as required in the current manual of survey instructions of the United States Department of the Interior, Bureau of Land Management or by a decree of a Court of Law and/or that the corner points mentioned in lines 3, 4 and 5 above were in conformance with the rules of the Michigan Board of Land Surveyors or by a Decree of a Court of Law; established, re-established, monumented, re-monumented, recovered; found as expressed below:

NOTE: Not more than 4 corners, all in the same town and range, may be recorded on this certificate.

A	B	C	D	E	F	G	H	I	J	K	L	M
2	6	5	4	3	2	1						
3												
4	7	8	9	10	11	12						
5												
6	18	17	16	15	14	13						
7												
8	19	20	21	22	23	24						
9												
10	30	29	28	27	26	25						
11												
12	31	32	33	34	35	36						
13												

A. Description of original monument and accessories and/or subsequent restoration:

- 1- Artemas Curtis 1852 L1 P. 272 LCRC L.Cavanagh 6-15-1989
- 1- Set Post Mon- Found 1/2" bar
- 2- 8" Spruce N86°W 131ks Wit- Spike in P.P. N20°E 46.82
- 14" Beech S64°E 25 lks Spike in 18" W. Pine N80°E 59.9
- P393 LCRC Spike in P.P. S40°E 69.0
- 1- 1/2" Iron in Mon Box in Spike in 18" Maple S40°W 50.72
- iter line Co. Rd. #100
- 2- 14" Oak S15°W 40.59 Oct 31, 1974 F. Arleth L. 299 P 105
- 14" Maple S50°W 71.15 Mon- Found 1/2" Bar
- ly 15, 1941 G.Henning Wit- None Given
- 1- Not Given THE HARDWOODS SUBDIVISION
- 2- Not Given L.1, pg.61 of Plats
- Mon-Not Given


July 3, 1989 L. 554 P 299 L. Cavanagh
Mon- None given
Wit- 14" B. Oak N46°E 61.0
15" B. Oak S20°E 68.2

3. Description of corner evidence found and/or method applied in restoring or reestablishing corner:

and 1/2"x34" bar in Southwest edge of asphalt of County Road 100 verified position by measurement to accessories of record. i accepted as a perpetuation of the position of the original corner.

C. Description of monument for corner and accessories established to perpetuate locating the position of the corner:

- 1- Set Std. Roscommon County Monument stamped " T23N, R3W, 31600, G-12" in monument box in Southwest edge asphalt of County Road #100
- 2- Set Roscommon County witness tag & nail in N. Side 63" Maple S80°W 75.15
- Found Spike NW side Utility Pole N25°E 46.92'
- Found Spike in E. side Utility Pole S34°E 68.96'
- Found Spike in S. side 20" W. Pine N85°E 59.94'
- Found Spike in SE side 21" Maple S45°W 50.74'
- Set carsonite post S65°W 14.6'

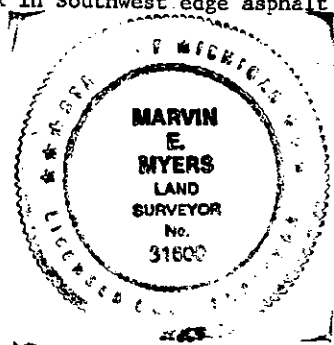

Signed by Marvin E. Myers

Date October 20, 1994

Surveyor's Michigan License No. 31600

LIBER 3 PAGE 174