

9241

FEB 16 1994

ROSCOMMON COUNTY REMONUMENTATION

Dec 28 10 28 AM '93

LAND CORNER RECORDATION CERTIFICATE
Filing Requirement of Act 74, Mich. P.A. 1970

COMMISSION

For corners in

Roscommon (County)	Located in:	Corner Code #
1. Public Land Survey	T 23N R 3W	I - 4
	T _____ R _____	_____
	T _____ R _____	_____
	T _____ R _____	_____
2. Property Controlling in Section	S _____ T _____ R _____	_____
	S _____ T _____ R _____	_____
3. Miscellaneous Property in Sec.	S _____ T _____ R _____	_____
	S _____ T _____ R _____	_____

REGISTER OF DEEDS

ROSCOMMON COUNTY
PEER GROUP APPROVAL
DATE 12-1-93

Register of Deeds Stamp & File Number

- 4. Lot No. _____, Recorded Plat _____
- 5. Private Claims _____

	A	B	C	D	E	F	G	H	I	J	K	L	M
2	6		5		4		3		2		1		
3													
4	7		8		9		10		11		12		
5													
6	18		17		16		15		14		13		
7													
8	19		20		21		22		23		24		
9													
10	30		29		28		27		26		25		
11													
12	31		32		33		34		35		36		
13													

I, Marvin E. Myers, in a field survey on Dec, 19 93, do hereby certify that under requirements of P.A. 74, Michigan P.A. of 1970, the corner points mentioned in lines 1 and 2 above were in conformance with regulations and rules therefore as required in the current manual of survey instructions of the United States Department of the Interior, Bureau of Land Management or by a decree of a Court of Law and/or that the corner points mentioned in lines 3, 4 and 5 above were in conformance with the rules of the Michigan Board of Land Surveyors or by a Decree of a Court of Law; established, re-established, monumented, re-monumented, recovered, found as expressed below:

NOTE: Not more than 4 corners, all in the same town and range, may be recorded on this certificate.


A. Description of original monument and accessories and/or subsequent restoration:

GLO - May 1852 A.Curtis Mon. - Post WIT: 12" Tamarack N36°W 24 lks. 10" Cedar S56°E 30 lks.	Oct. 1990 L.Cavanagh Mon. - Set 3/4" Bar WIT: 8" Cedar N60°E 32.65' 2" Spruce N40°W 27.70' 7" Cedar S65°W 9.70' 8" Cedar S45°E 23.75'	Nov. 1992 M.E.Myers Mon. 3/4" bar WIT: 8" Cedar N60°E 32.65' 2" Spruce N40°W 27.70' 7" Cedar S65°W 9.70' 8" Cedar S45°E 23.75'
--	--	---

B. Description of corner evidence found and/or method applied in restoring or reestablishing corner:
Found 3/4" bar verified position by measurement to accessories of record and accepted as the best available evidence of the position of the Original Corner.

C. Description of monument for corner and accessories established to perpetuate locating the position of the corner:

Mon-Set Standard Roscommon County 2"x21" Monument
Wit- Nail & tag in S. side 8" Cedar S70°W 10.01
Nail & tag in W side 6" Birch S4°W 20.86
Nail & tag in SW side 8" Cedar S43°E 24.13
Nail & tag in S. side 8" Cedar N63°E 33.03

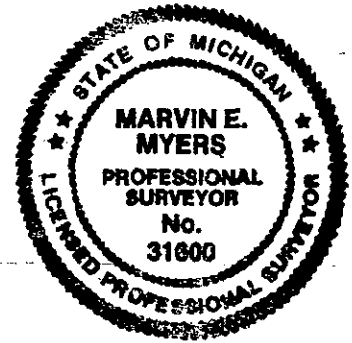

Signed by Marvin E. Myers Date Dec 27, 1993
Surveyor's Michigan License No. 31600

DATE Dec 7, 1993 PEER GROUP APPROVAL