

**SURVEY &
REMONUMENTATION**

MAY 28 1997

COMMISSION LAND CORNER RECORDATION CERTIFICATE
Filing Requirement of Act 74, Mich. P.A. 1970

For corners in <u>Roscommon</u> <small>(County)</small>	Located In:	Corner Code #
1. Public Land Survey	T <u>23N</u> R <u>3W</u>	<u>J-7</u>
	T _____ R _____	_____
	T _____ R _____	_____
	T _____ R _____	_____
2. Property Controlling in Section	S _____ T _____ R _____	_____
	S _____ T _____ R _____	_____
3. Miscellaneous Property in Section	S _____ T _____ R _____	_____
	S _____ T _____ R _____	_____
4. Lot No. _____, Recorded Plat _____		
5. Private Claims _____		

STATE OF MICHIGAN
ROSCOMMON COUNTY
RECORDED

26 SEP 96 3:38 P.M.

ROBERT W. SMITH
TO BE FILED IN LIBER 3 DEEDS
Register of Deeds Stamp & File Number

I, Larry L. Cavanagh, in a field survey on May, 19 96, do hereby certify that under requirements of P.A. 74, Michigan P.A. of 1970, the corner points mentioned in lines 1 and 2 above were in conformance with regulations and rules therefore as required in the current manual of survey instructions of the United States Department of the Interior, Bureau of Land Management or by a decree of a Court of Law and/or that the corner points mentioned in lines 3, 4 and 5 above were in conformance with the rules of the Michigan Board of Professional Surveyors or by a Decree of a Court of Law; established, re-established, monumented, re-monumented, recovered, found as expressed below:

A	B	C	D	E	F	G	H	I	J	K	L	M
2	6	5	4	3	2	1						
3												
4	7	8	9	10	11	12						
5												
6	18	17	16	15	14	13						
7												
8	19	20	21	22	23	24						
9												
10	30	29	28	27	26	25						
11												
12	31	32	33	34	35	36						
13												

NOTE: Not more than 4 corners, all in the same town and range, may be recorded on this certificate.

A. Description of original monument and accessories and/or subsequent restoration:

Artimus Curtis set original
post April 1852
Hemlock 12" N67W 13 links
W. Pine 15" S53E 26 links

B. Description of corner evidence found and/or method applied in restoring or reestablishing corner:

No evidence of the original corner was found.
Corner was re-established by single proportionate distance


**ROSCOMMON COUNTY
PEER GROUP APPROVAL
DATE Aug 16, 1996**

Marvin E. Myers
**Marvin E. Myers, P.S.
County Surveyor**

C. Description of monument for corner and accessories established to perpetuate locating the position of the corner:

Set Roscommon County Standard Monument (stamped 17614)
wit: N & T 12" Twin Maple N40°W 14.96'
N & T 6" Cedar S30°W 35.12'
N & T 10" Maple S45°E 24.62'
N & T 12" Maple S65°E 17.21'
Set carsonite post South 1.0'

A reestablishment of the position of the Original Government Corner.

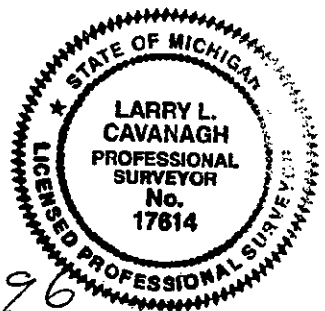

Signed by Larry L. Cavanagh
Surveyor's Michigan License No. 17614

Date 9-16-96

FORM APPROVED BY MICHIGAN STATE BOARD OF PROFESSIONAL SURVEYORS, JAN. 28, 1971
REVISED MAY 14, 1975
REVISED JAN., 1983

LIBER 3 PAGE 329