

**SURVEY &
REMONUMENTATION**

MAY 28 1997

COMMISSION

9161

**ROSCOMMON COUNTY REMONUMENTATION
LAND CORNER RECORDATION CERTIFICATE
Filing Requirement of Act 74, Mich. P.A. 1970**

For corners in

<u>ROSCOMMON</u> (County)	Located in:	Corner Code #
1. Public Land Survey	T <u>23</u> NR <u>3W</u>	<u>L - 5</u>
	T <u> </u> R <u> </u>	<u> </u>
	T <u> </u> R <u> </u>	<u> </u>
	T <u> </u> R <u> </u>	<u> </u>
2. Property Controlling in Section	S <u> </u> T <u> </u> R <u> </u>	<u> </u>
	S <u> </u> T <u> </u> R <u> </u>	<u> </u>
3. Miscellaneous Property in Sec.	S <u> </u> T <u> </u> R <u> </u>	<u> </u>
	S <u> </u> T <u> </u> R <u> </u>	<u> </u>

STATE OF MICHIGAN
ROSCOMMON COUNTY
RECORDED

6 DEC 96 4:25 P.M.

ROBERT W. SMITH
REGISTER OF DEEDS

TO BE FILED IN LIBER 3 OF LAND CORNERS
Register of Deeds Stamp & File Number

4. Lot No. _____, Recorded Plat _____
5. Private Claims _____

I, TIMOTHY L. LAPHAM, in a field survey on July, 15, 1996 do hereby state that under requirements of P.A. 74, Michigan P.A. of 1970, the corner points mentioned in lines 1 and 2 above were in conformance with regulations and rules therefore as required in the current manual of survey instructions of the United States Department of the Interior, Bureau of Land Management or by a decree of a Court of Law and /or that the corner points mentioned in lines 3, 4 and 5 above were in conformance with the rules of the Michigan Board of Land Surveyors or by a Decree of a Court of Law; established, re-established, monumented, recovered, found as expressed below:

A	B	C	D	E	F	G	H	I	J	K	L	M
1												
2	6		5		4		3		2		1	
3												
4	7		8		9		10		11		12	
5												*
6	18		17		16		15		14		13	
7												
8	19		20		21		22		23		24	
9												
10	30		29		28		27		26		25	
11												
12	31		32		33		34		35		36	
13												

NOTE: Not more than 2 corners, all in the same town and range, may be recorded on this certificate.

A. Description of original monument and accessories and/or subsequent restoration:

L - 5 GLO CURTIS 1852, SET POST, 8" W. BIRCH N50W 3 LINKS, 6" HEMLOCK S55E 4 LINKS; LCRC, JOHNSON 1/28/92 (REC 1/28/92, L1, P304), DNR MON, 6" CHERRY S01E 15.85', 4" OAK S84W 38.92', 4" CHERRY N68W 34.35', 6" CHERRY N10E 53.20'; LCRC, ROSER 5/4/94 (REC 6/6/94, L1, P325), RE-RECORDED JOHNSON'S LCRC

B. Description of corner evidence found and/or method applied in restoring or reestablishing corner:

L - 5 NO EVIDENCE OF GLO FOUND. FOUND DNR MONUMENT IN ACCORD WITH RECORDED LCRC. ACCEPTED FOUND MONUMENT AS BEST EVIDENCE OF THE POSITION OF THE ORIGINAL CORNER. SEE DOSSIER FOR ADDITIONAL INFORMATION.

**ROSCOMMON COUNTY
PEER GROUP APPROVAL**

DATE AUG 16, 1996


Marvin E. Myers MRA

Marvin E. Myers, P.S.

C. Description of monument for corner and accessories established to perpetuate locating the position of ~~Corner~~ Surveyor

L - 5 FOUND DNR MONUMENT FROM WHICH:
S01E 15.85' 6" CHERRY N68W 34.35' 4" CHERRY
S84W 38.92' 4" OAK N10E 53.20' 6" CHERRY

Nails and tags in all trees

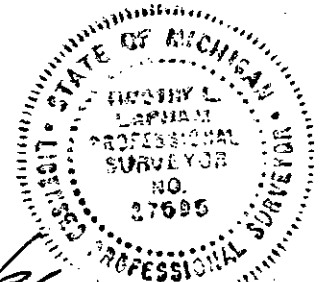

Signed by *Timothy L. Lapham*
Surveyor's Michigan License No. 27595

Date 10/1/96