

LAND CORNER RECORDATION CERTIFICATE
Filing Requirement of Act 74, Mich. P.A. 1970

For corners in

<u>Roscommon</u> <small>(County)</small>	Located In:	Corner Code #
1. Public Land Survey	T ___ R ___	_____
	T ___ R ___	_____
	T ___ R ___	_____
2: Property Controlling in Section	S 30 T 23N R 4W	1
	S 30 T 23N R 4W	10
3. Miscellaneous Property in Sec.	S ___ T ___ R ___	_____
	S ___ T ___ R ___	_____

Register of Deeds Stamp & File Num

4. Lot No. _____, Recorded Plat _____

5. Private Claims _____

I, Craig W. McVean, in a field survey on May 19 97 do hereby state that under requirements of P.A. 74, Michigan P.A. of 1970, the corner points mentioned in lines 1 and 2 above were in conformance with regulations and rules therefore as required in the current manual of survey instructions of the United States Department of the Interior, Bureau of Land Management or by a decree of a Court of Law and for that the corner points mentioned in lines 3, 4 and 5 above were in conformance with the rules of the Michigan Board of Land Surveyors or by a Decree of a Court of Law; established, re-established, monumented, recovered, found as expressed below:

NOTE: Not more than 2 corners, all in the same town and range, may be recorded on this certificate.

A. Description of original monument and accessories and/or subsequent restoration:



- | | |
|--|--|
| 1 - R. Ostling - 1954 - Found Iron Shafting in center trail road and in line with fence S. N8° 30'E 61.0' 18" W. Oak N32° 30' W 67.3' 24" B. Oak | 10 - R. Ostling - 1954 - Set 1/2" Bar Mkd. BT N. Pine 8" S64° 17.6' SW Corner HSE. N40°E |
| - G. Henning 1959 Rd. Survey Iron Rod. Same Wit's as R.O. | - River Trail Sub L. 3 P. 71 - G. Ostling-1957 |
| | - G. Henning 1959 - Co. Rd. 300 Rd. Survey 1/2" x 24" Iron Bar |

B. Description of corner evidence found and/or method applied in restoring or reestablishing corner:

- | | |
|--|---|
| 1 - W 1/16 Sec. 19 & 30 - Found Axel Shaft Iron per R.O. & G.H. Fits Fence occupation to south. This monument doesn't fit a GLO proportional position E&W but has been used and occupied as the W 1/16 Corner since at least 1954. Thus this occupied monument is accepted as the best available evidence of the corner. | 10 - S 1/16 Cor. Sec. 30, T23N, R4W & Sec. 25, T23N, R5W - FND. 1/2" Iron Rod per R. Ostling, plat & G. Henning. Iron is 9'E of CL. 300 Rd. & 25' S of Phy CL. Myrtle Rd. to E. Monument accepted as the best available evidence of the position of the corner. |
|--|---|

C. Description of monument for corner and accessories established to perpetuate locating the position of the corner:

- | | |
|--|---|
| 1 - Raised Axel Iron to surface w/ 2" A.C. on 5/8" x 15" Rebar. South 30' Carsonite Post. N10°E 61.50' to Set N&T in E. Side 25" W. Oak - (RO) S45°W 59.08' to Set N&T in SE Side 8" W. Pine N15°W 40.90' to Set N&T in W. Side 6" R. Oak S25°E 64.90' to Set N&T in SW Side 14" W. Pine | 10 - Replace 1/2" x 30" Iron Rod with 2" A.C. on 5/8" x 34" Rebar. East 33' to Loose Conc. Plat Mon. & Set Carsonite Post. S64°W 78.16' to Set N&T in S. Side 18" R. Pine (RO) N40°E 83.47' to SW Cor. Wood Siding of HSE #1262 (RO) S70°E 40.59' to N&T in S. Side 6" W. Pine N60°W 55.95' to N&T in N. Side 4" R. Pine. |
|--|---|

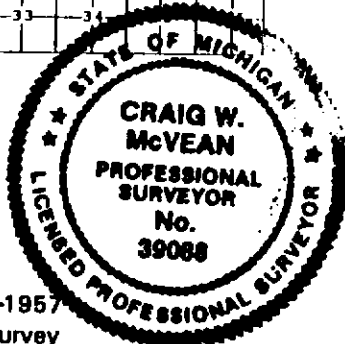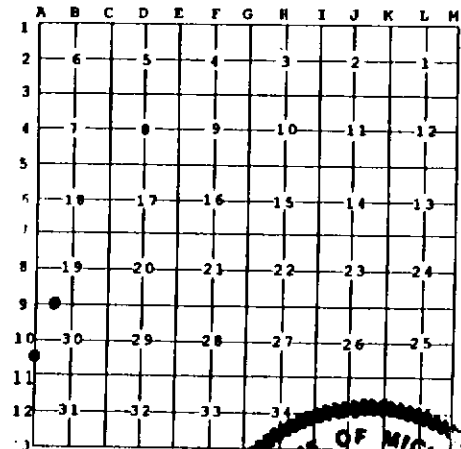

Signed by Craig W. McVean
 Surveyor's Michigan License No. 39088

Date 3/6/1998