


LAND CORNER RECORDATION CERTIFICATE

Filing Requirement of Act 74, Mich. PA 1970

For Corners In: Roscommon (County)	Located In	Corner Code #
1. Public Land Survey	T <u>23N</u> R <u>4W</u>	<u>L-2</u>
	T _____ R _____	_____
2. Property Controlling in Section	S <u>1</u> T <u>23N</u> R <u>4W</u>	<u>9</u>
	S _____ T _____ R _____	_____
3. Miscellaneous Property in Section	S _____ T _____ R _____	_____
	S _____ T _____ R _____	_____
4. Lot No: _____	Recorded Plat: _____	
5. Private Claims: _____		

Register of Deeds Stamp & File Number

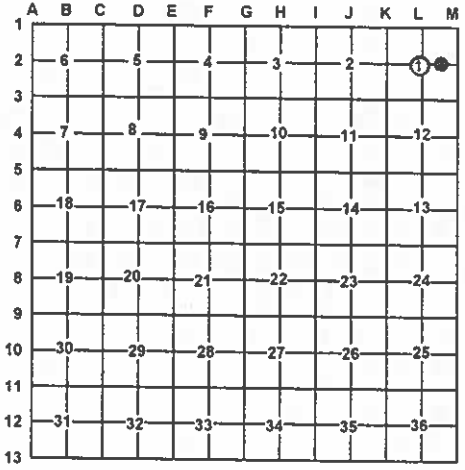

I, Carl T. Kiiskila, in a field survey on October 9, 2007 do hereby state that under requirements of PA 74, Michigan PA of 1970, the corner points mentioned in lines 1 and 2 above were in conformance with regulations and rules therefore as required in the current manual of survey instructions of the United States Department of the Interior, Bureau of Land Management or by a decree of a Court of Law and/or that the corner points mentioned in lines 3, 4 and 5 above were in conformance with the rules of the Michigan Board of Land Surveyors or by a Decree of a Court of Law; established, re-established, monumented, recovered, found as expressed below:

NOTE: Not more than 2 corners, all in the same town and range, may be recorded on this certificate.

- A. Description of original monument and accessories and/or subsequent restoration:**
- L-2 This corner position was not established during the original government survey.
 - 9- This corner position was not established during the original government survey.

- B. Description of corner evidence found and/or method applies in restoring or re-establishing corner:**
- L-2 Established the center of section by the intersection of the North-South and East-West quarter lines.
 - 9- Established the Northeast corner of the Northwest quarter of the Southeast quarter as per B.L.M. instruction for the subdivision of a section.

- C. Description of monument for corner and accessories established to perpetuate locating the position of the corner:**
- L-2 Set 5/8" X 32" rerod with P.S. cap #33981
Wit: Set nail and tag in Northeast side of 4" Oak S61°E 27.52'
Set nail and tag in East side of 18" Oak S26°E 54.56'
Set nail and tag in Southwest side of 7" Spruce N65°W 20.05'
Set nail and tag in East side of 8" Spruce N16°W 12.74'
Carsonite Post North 1'±
 - 9- Set 5/8" X 32" rerod with P.S. cap #33981
Wit: Set nail and tag in South side of 6" Oak N84°E 14.98'
Set nail and tag in West side of 10" Oak N15°E 47.46'
Set nail and tag in Southeast side of 9" Oak S60°W 87.10'
Set nail and tag in Northeast side of 4" Oak S10°E 51.65'
Carsonite Post North 1'±

Signed by: Carl T. Kiiskila
Surveyor's Michigan License No.: 33981

Date: 10-18-07

