

**SURVEY &
REMONUMENTATION**

8290

APR 24 1995

LAND CORNER RECORDATION CERTIFICATE
Filing Requirement of Act 74, Mich. P.A. 1970

STATE OF MICHIGAN
ROSCOMMON COUNTY
RECORDED

10 NOV 94 3:28 P.M.

ROBERT W. SMITH
REGISTER OF DEEDS

ROSCOMMON COUNTY
PEER GROUP APPROVAL *MEM*

DATE 9-15-94
Register of Deeds Stamp & File Number

For corners in

COMMISSION

<u>Roscommon</u> (County)	Located In:	Corner Code #
1. Public Land Survey	T 23N R 4W	E - 3
	T _____ R _____	_____
	T _____ R _____	_____
	T _____ R _____	_____
2. Property Controlling in Section	S _____ T _____ R _____	_____
	S _____ T _____ R _____	_____
3. Miscellaneous Property in Sec.	S _____ T _____ R _____	_____
	S _____ T _____ R _____	_____

4. Lot No. _____, Recorded Plat _____
5. Private Claims _____

	A	B	C	D	E	F	G	H	I	J	K	L	M
2	6	5	4	3	2	1							
3			●										
4	7	8	9	10	11	12							
5													
6	18	17	16	15	14	13							
7													
8	19	20	21	22	23	24							
9													
10	30	29	28	27	26	25							
11													
12	31	32	33	34	35	36							
13													

I, Marvin E. Myers, in a field survey on September 8, 19 94, do hereby certify that under requirements of P.A. 74, Michigan P.A. of 1970, the corner points mentioned in lines 1 and 2 above were in conformance with regulations and rules therefore as required in the current manual of survey instructions of the United States Department of the Interior, Bureau of Land Management or by a decree of a Court of Law and/or that the corner points mentioned in lines 3, 4 and 5 above were in conformance with the rules of the Michigan Board of Land Surveyors or by a Decree of a Court of Law; established, re-established, monumented, re-monumented, recovered, found as expressed below:


NOTE: Not more than 4 corners, all in the same town and range, may be recorded on this certificate.

A. Description of original monument and accessories and/or subsequent restoration:
GLO-Artemas Curtis 1852
Mon-Post
WIT: 8" B.Ash N13°W 15 lks.
8" Cedar S69°W 35 lks.
N. side Muskegon River S. 627.00'
W. side Muskegon River East

B. Description of corner evidence found and/or method applied in restoring or reestablishing corner:
No evidence of the original monument was found. Re-established position at intersection of river ties East and South and is accepted as a careful and faithful re-establishment of the position of the corner.

C. Description of monument for corner and accessories established to perpetuate locating the position of the corner:

Mon-Set 3/4" ID X 48" Galvanized Steel Pipe & Cap stamped "MEM 31600"
WIT: Nail & Tag top wood stake North 10.00'
Nail & Tag top wood stake South 10.00'
Nail & Tag top wood stake West 10.00'
Nail & Tag top wood stake East 10.00'
Carsonite Post East 3.00'
F-3 S87°41'49"E 2657.67'
E-4 S00°14'46"E 2614.95'

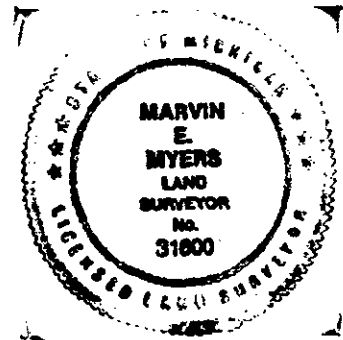

Signed by Marvin E. Myers Date October 11, 1994
Surveyor's Michigan License No. 31600