

ROSCOMMON COUNTY SURVEY & PEER GROUP APPROVAL DOCUMENTATION

DATE Dec 13, 1994

LAND CORNER RECORDATION CERTIFICATE

STATE OF MICHIGAN
ROSCOMMON COUNTY
RECORDED

Requirement of Act 74, Mich. P.A. 1970

For corners in

ROSCOMMON
(County)

COMMISSION

Corner Code #

21 DEC 94 8:37 A.M.

ROBERT W. SMITH
REGISTER OF DEEDS

- | | | |
|---------------------------------------|--------------------------|------------|
| 1. Public Land Survey | T <u>23N</u> R <u>4W</u> | <u>E-8</u> |
| | T _____ R _____ | _____ |
| | T _____ R _____ | _____ |
| | T _____ R _____ | _____ |
| 2. Property Controlling in Section | S _____ T _____ R _____ | _____ |
| | S _____ T _____ R _____ | _____ |
| 3. Miscellaneous Property in Sec. | S _____ T _____ R _____ | _____ |
| | S _____ T _____ R _____ | _____ |
| 4. Lot No. _____, Recorded Plat _____ | | |
| 5. Private Claims _____ | | |

Register of Deeds Stamp & File Number

I, Marvin E. Myers, in a field survey on Dec 12, 19 94 do hereby certify that under requirements of P.A. 74, Michigan P.A. of 1970, the corner points mentioned in lines 1 and 2 above were in conformance with regulations and rules therefore as required in the current manual of survey instructions of the United States Department of the Interior, Bureau of Land Management or by a decree of a Court of Law and/or that the corner points mentioned in lines 3, 4 and 5 above were in conformance with the rules of the Michigan Board of Land Surveyors or by a Decree of a Court of Law; established, re-established, monumented, re-monumented, recovered, found as expressed below:

	A	B	C	D	E	F	G	H	I	J	K	L	M
2	6	5	4	3	2	1							
3													
4	7	8	9	10	11	12							
5													
6	18	17	16	15	14	13							
7													
8	19	20	21	22	23	24							
9													
10	30	29	28	27	26	25							
11													
12	31	32	33	34	35	36							
13													


NOTE: Not more than 4 corners, all in the same town and range, may be recorded on this certificate.

A. Description of original monument and accessories and/or subsequent restoration:
 GLO-Artemas Curtis 1852 Survey by -Unknown Surveyor Date unknown
 Mon-Post Mon- unknown
 Wit- 5" Tamarack S75°E 131 lks Wit- none given
 5" Tamarack S07°W 151 lks Corner location midway and on line between E-7 and E-9

RCRC plans L2, P415
 Mon- not given
 Wit- Mon Box on Section line
 South of corner. (NOTE:
 Monument Box is not on
 Section line)

B. Description of corner evidence found and/or method applied in restoring or reestablishing corner:
 Measured to corners North - South set corner midway and on line and accepted as a careful and faithful reestablishment of the position of the original corner

C. Description of monument for corner and accessories established to perpetuate locating the position of the corner:
 Mon-Set Standard Roscommon County monument mark cap " 31600".
 Wit-Set nail & tag NW side 3" W. Birch S68°30'W 63.14
 Set nail & tag NE side 6" Elm N30°30'W 52.38
 East Edge of "Stop Sign" post S29°W 49.02
 Set Carsonite post S83°E 25.47
 N01°23'04"E 2624.57 to E-7
 S01°23'04"W 2624.37 to E-9
 Found 1" bar in Mon. Box S04°E 77.15

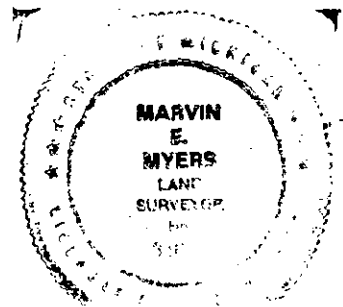

Signed by Marvin E. Myers Date DEC 15, 1994

Surveyor's Michigan License No. 31600

FORM APPROVED BY MICHIGAN STATE BOARD OF LAND SURVEYORS, JAN. 28, 1971
 REVISED MAY 14, 1975
 REVISED JAN., 1983

LIBER 3 PAGE 203