

REMONUMENTATION

STATE OF MICHIGAN
COUNTY OF ROSCOMMON

ROSCOMMON COUNTY REMONUMENTATION

LAND CORNER RECORDATION CERTIFICATE
Filing Requirement of Act 74, Mich. P.A. 1970

9084 FEB 18 1994

Dec 21 10 51 AM '93

For corners in

COMMISSION

Robert L. Lapham
REGISTERED PROFESSIONAL SURVEYOR

ROSCOMMON (County)	Located In:	Corner Code #
1. Public Land Survey	T <u>23N</u> R <u>4W</u>	<u>E-11</u>
	T _____ R _____	_____
	T _____ R _____	_____
	T _____ R _____	_____
2. Property Controlling in Section	S _____ T _____ R _____	_____
	S _____ T _____ R _____	_____
3. Miscellaneous Property in Sec.	S _____ T _____ R _____	_____

ROSCOMMON COUNTY
PEER GROUP APPROVAL
DATE 11/30/93

TO BE FILED IN LIBER 3 OF LAND CORNERS
Register of Deeds Stamp & File Number

4. Lot No. _____, Recorded Plat _____
5. Private Claims _____


	A	B	C	D	E	F	G	H	I	J	K	L	M
2	6	5	4	3	2	1							
3													
4	7	8	9	10	11	12							
5													
6	18	17	16	15	14	13							
7													
8	19	20	21	22	23	24							
9													
10	30	29	28	27	26	25							
11													
12	31	32	33	34	35	36							
13													

TIMOTHY L. LAPHAM, in a field survey on November, 19 93, do hereby certify that under requirements of P.A. 74, Michigan P.A. of 1970, the corner points mentioned in lines 1 and 2 above were in conformance with regulations and rules therefore as required in the current manual of survey instructions of the United States Department of the Interior, Bureau of Land Management or by a decree of a Court of Law and/or that the corner points mentioned in lines 3, 4 and 5 above were in conformance with the rules of the Michigan Board of Land Surveyors or by a Decree of a Court of Law; established, re-established, monumented, re-monumented, recovered, found as expressed below:

NOTE: Not more than 4 corners, all in the same town and range, may be recorded on this certificate.

A. Description of original monument and accessories and/or subsequent restoration:

E-11: 1852, A.CURTIS, POST, SPRUCE 5" N55W 72LKS, SPRUCE 5" S55W 1.08CH;
DATE UNKNOWN, SURVEYOR UNKNOWN, LCRC 2-427, CORNER MATERIAL, 2 WITNESSES;

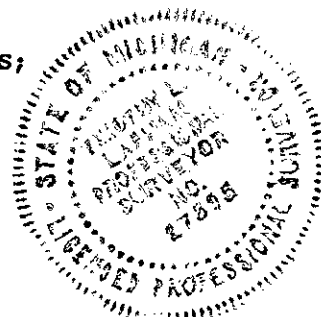

B. Description of corner evidence found and/or method applied in restoring or reestablishing corner:

E-11: NO EVIDENCE OF GLO CORNER OR WITNESSES. FENCES REFERENCED IN LCRC NOT FOUND. FOUND 1" X 24" AXLE SHAFT. BASED ON TRAVERSING FOUND CORNER IS AT DISTANCE PREVIOUSLY SURVEYED AND ON SAME LINE AS SW CORNER TO WEST 1/4 CORNER. ACCEPTED FOUND CORNER AS BEST EVIDENCE OF ORIGINAL POSITION OF LOCATION OF CORNER. THIS CORNER ESTABLISHED IN ROSCOMMON COUNTY REMONUMENTATION PROGRAM. SEE DOSSIER FOR DETAILS.

C. Description of monument for corner and accessories established to perpetuate locating the position of the corner:

E-11: SET 2" X 33" CAST IRON MONUMENT WITH BRASS PLATE
AZ 0° 0.51' CARSONITE SURVEY MARKER POST
AZ 270° 16.'+/- CENTER LINE OF OLD ROAD BED
AZ 160° 47.30' SPIKE IN NE FACE 3" TAMARACK
AZ 90° (ALONG SECTION LINE) CALCULATED 1584.4' TO CENTER LINE OF NORTH BOUND US-27 EXPRESSWAY PAVEMENT

Signed by *Timothy L. Lapham*

Date 12/20/93

Surveyor's Michigan License No. 27595

FORM APPROVED BY MICHIGAN STATE BOARD OF LAND SURVEYORS, JAN. 28, 1971
REVISED MAY 14, 1975
REVISED JAN., 1983

Date 12-7-93 Peer Group Approved

LIBER 3 PAGE 48