

ROSCOMMON COUNTY REMONUMENTATION

9076 FEB 18 1994

LAND CORNER RECORDATION CERTIFICATE
Filing Requirement of Act 74, Mich. P.A. 1970

Dec 21 10 51 AM '93

For corners in COMMISSION

Robert L. Lapham
REGISTERED PROFESSIONAL SURVEYOR

ROSCOMMON (County)	Located In:	Corner Code #
1. Public Land Survey	T <u>23N</u> R <u>4W</u>	<u>E-13</u>
	T _____ R _____	_____
	T _____ R _____	_____
	T _____ R _____	_____
2. Property Controlling in Section	S _____ T _____ R _____	_____
	S _____ T _____ R _____	_____
3. Miscellaneous Property in Sec.	S _____ T _____ R _____	_____
	S _____ T _____ R _____	_____
4. Lot No. _____, Recorded Plat _____		
5. Private Claims _____		

ROSCOMMON COUNTY
PEER GROUP APPROVAL
DATE 11/30/93

TO BE FILED IN LIBER 3 OF LAND CORNERS
Register of Deeds Stamp & File Number

I, TIMOTHY L. LAPHAM, in a field survey on November, 19 93, do hereby certify that under requirements of P.A. 74, Michigan P.A. of 1970, the corner points mentioned in lines 1 and 2 above were in conformance with regulations and rules therefore as required in the current manual of survey instructions of the United States Department of the Interior, Bureau of Land Management or by a decree of a Court of Law and/or that the corner points mentioned in lines 3, 4 and 5 above were in conformance with the rules of the Michigan Board of Land Surveyors or by a Decree of a Court of Law; established, re-established, monumented, re-monumented, recovered, found as expressed below:

	A	B	C	D	E	F	G	H	I	J	K	L	M
2	6	5	4	3	2	1							
3													
4	7	8	9	10	11	12							
5													
6	18	17	16	15	14	13							
7													
8	19	20	21	22	23	24							
9													
10	30	29	28	27	26	25							
11													
12	31	32	33	34	35	36							
13													


NOTE: Not more than 4 corners, all in the same town and range, may be recorded on this certificate.

A. Description of original monument and accessories and/or subsequent restoration:

E-13: 1838, J.BRINK, POST, BEECH 9" N36E 25L, BEECH 15" N55W 8L;
DATE UNKNOWN, SURVEYOR UNKNOWN LCRC 2-427, COR MATERIAL, NO WITS; DATE AND SURVEYOR UNKNOWN, SURVEY IN E 1/2 OF E 1/2 OF SEC 32, NO CORNER INFO;
7/19/1989, L. CAVANAGH, LCRC 1-273, COR MAT, 4 WITS;
7/19/1989, L.CAVANAGH, SURVEY NOT REC, NO NEW INFO;
6/26/1991, L. CAVANAGH, SURVEY 605-687, COR MAT, 3 WITS;

B. Description of corner evidence found and/or method applied in restoring or reestablishing corner:

E-13: FOUND 1/2"X12" REROD OVER 3/8" SQUARE SHANK X 10" SPIKE OVER 3/4" SOLID ROD WITH 1/4"X1" BAR BESIDE IT IN A STONE PILE IN MON BOX IN CENTERLINE M-55 & MICHELSON ROAD (CO. RD. 303) N. & NELLVILLE ROAD S
SPIKE IN POWER POLE N48W 41.8'
SPIKE IN POWER POLE N30E 45.9'
SPIKE IN POWER POLE S45W 41.0'
MOST WESTERLY BOLT OF 4 BOLT SET IN METAL PLATE S38E 50.7'
ACCEPTED FOUND CORNER AS BEST EVIDENCE OF POSITION OF ORIGINAL CORNER.
THIS CORNER ESTABLISHED IN ROSCOMMON COUNTY REMONUMENTATION PROGRAM.
SEE DOSSIER FOR DETAILED REPORT.

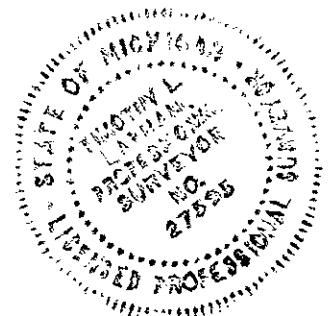

C. Description of monument for corner and accessories established to perpetuate locating the position of the corner:

E-13: SET 2" X 11" CAST IRON MONUMENT WITH BRASS ROSCOMMON COUNTY PLATE IN MONUMENT BOX
AZ 318° 41.81' FOUND SPIKE IN SW FACE UTILITY POLE
AZ 32° 45.92' FOUND SPIKE IN NW FACE TIGHT POLE
AZ 228° 41.01' FOUND SPIKE IN NW FACE UTILITY POLE
AZ 142° 50.7' MOST WESTERLY BOLT IN 4 BOLT SET IN METAL PLATE PROTRUDING 0.4' ABOVE PLATE

Signed by *Timothy L. Lapham*

Date 12/20/93

Surveyor's Michigan License No. 27595

Date 11/30/93

Peer Group Approved

LIBER 3 PAGE 40