

8289 SURVEY & REMONUMENTATION

APR 24 1995

LAND CORNER RECORDATION CERTIFICATE

Filing Requirement of Act 74, Mich. P.A. 1970

STATE OF MICHIGAN
ROSCOMMON COUNTY
RECORDED

For corners in

Roscommon (County)

COMMISSION Located In:

Corner Code #

10 NOV 94 3:28 P.M.

ROBERT W. SMITH
REGISTER OF DEEDS

ROSCOMMON COUNTY

PEER GROUP APPROVAL *MEM*

DATE 9-15-94

Register of Deeds Stamp & File Number

1. Public Land Survey	T	23N	R	4W	F - 5
	T		R		
	T		R		
	T		R		
2. Property Controlling in Section	S		T	R	
	S		T	R	
3. Miscellaneous Property in Sec.	S		T	R	
	S		T	R	

4. Lot No. _____, Recorded Plat _____
5. Private Claims _____

Marvin E. Myers, in a field survey on September 8, 19 94

do hereby certify that under requirements of P.A. 74, Michigan P.A. of 1970, the corner points mentioned in lines 1 and 2 above were in conformance with regulations and rules therefore as required in the current manual of survey instructions of the United States Department of the Interior, Bureau of Land Management or by a decree of a Court of Law and/or that the corner points mentioned in lines 3, 4 and 5 above were in conformance with the rules of the Michigan Board of Land Surveyors or by a Decree of a Court of Law; established, re-established, monumented, re-monumented, recovered, found as expressed below:

	A	B	C	D	E	F	G	H	I	J	K	L	M
2	6		5		4		3		2		1		
3													
4	7		8		9		10		11		12		
5													
6	18		17		16		15		14		13		
7													
8	19		20		21		22		23		24		
9													
10	30		29		28		27		26		25		
11													
12	31		32		33		34		35		36		
13													

NOTE: Not more than 4 corners, all in the same town and range, may be recorded on this certificate.

A. Description of original monument and accessories and/or subsequent restoration:


- | | | |
|--------------------------------|--------------------------------|-------------------------------------|
| Mon-Set Post | MDOT 8-5-60 | RCRC L.2, pg.404 LCRC |
| WIT: 4" Spruce N35°W 104 lks. | Mon-Fd. 1" Steel Road | Mon-1" Steel Forming Pin in Mon Box |
| 4" Tamarack S20°E 42 lks. | WIT: Fence corner S46°E 47.39' | S.B. Lane US 27 |
| MDOT-Ward Abrahamson Nov. 1958 | Larry Cavanagh 5-26-76 | WIT: Fence corner S46°E 47.39' |
| Mon-Fd. 1" Steel Rod | Mon-L.317, pg.401 | 6" Poplar N48°E 73.63' |
| WIT: Fence corner S46°E 47.39' | WIT: Fence corner S46°E 47.39' | 7" Poplar N36°W 48.08' |
| 6" Poplar N48°E 13.63' | 6" Poplar N48°E 73.63' | |
| 7" Poplar N36°W 48.08' | 7" Poplar N36°W 48.08' | |

3. Description of corner evidence found and/or method applied in restoring or reestablishing corner:

3/4" Bar in Monument Box in centerline South Bound US 27 and accepted as the best available evidence of the position of the original corner.

C. Description of monument for corner and accessories established to perpetuate locating the position of the corner:

- Mon-Set Std. Roscommon Cty. Mon. stamped "F-5 T23N R4W 31600" over 3/4" Bar in Mon. Box in C S.B. US 27
 WIT: Set Wit. Tag & Nail S. side 10" Poplar S60°W 107.45'
 Set Wit. Tag & Nail W. side 12" Poplar N07°W 101.93'
 Set Nail N. side 10" Poplar N84°W 196.02'
 Set Carsonite Post (top) East 50.00'
 E-5 N88°20'07"W 2640.72'
 G-5 S88°43'07"E 2638.92'

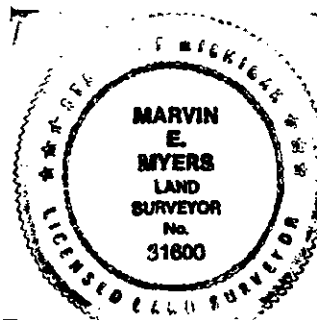

Signed by Marvin E. Myers

Date OCT-18, 1994

Surveyor's Michigan License No. 31600