

Dec 21 10 51 AM '93

ROSCOMMON COUNTY REMONUMENTATION

LAND CORNER RECORDATION CERTIFICATE  
Filing Requirement of Act 74, Mich. P.A. 1970

9074

FEB 13 1994

For corners in

ROSCOMMON (County)	Located In:	Corner Code #
1. Public Land Survey	T 23N R 4W	G-11
	T R	
	T R	
	T R	
2. Property Controlling in Section	S T R	
	S T R	
3. Miscellaneous Property in Sec.	S T R	
	S T R	

ROSCOMMON COUNTY  
PEER GROUP APPROVAL  
DATE 11/30/93

TO BE FILED IN LIBER 3 OF LAND CORNERS  
Register of Deeds Stamp & File Number

4. Lot No. \_\_\_\_\_, Recorded Plat \_\_\_\_\_  
5. Private Claims \_\_\_\_\_

	A	B	C	D	E	F	G	H	I	J	K	L	M
2	6	5	4	3	2	1							
3													
4	7	8	9	10	11	12							
5													
6	18	17	16	15	14	13							
7													
8	19	20	21	22	23	24							
9													
10	30	29	28	27	26	25							
11													
12	31	32	33	34	35	36							
13													

I, TIMOTHY L. LAPHAM, in a field survey on November, 19 93, do hereby certify that under requirements of P.A. 74, Michigan P.A. of 1970, the corner points mentioned in lines 1 and 2 above were in conformance with regulations and rules therefore as required in the current manual of survey instructions of the United States Department of the Interior, Bureau of Land Management or by a decree of a Court of Law and/or that the corner points mentioned in lines 3, 4 and 5 above were in conformance with the rules of the Michigan Board of Land Surveyors or by a Decree of a Court of Law; established, re-established, monumented, re-monumented, recovered, found as expressed below:


NOTE: Not more than 4 corners, all in the same town and range, may be recorded on this certificate.

A. Description of original monument and accessories and/or subsequent restoration:

G-11: 1838, J. BRINK, POST, ELM 10" N25E 22LKS, Y BIRCH 14" S50W 11LKS;  
DATE UNKNOWN, SURVEYOR UNKNOWN, LCRC 2-428, CORNER MATERIAL, 1 WITNESS;  
8/1945, HENNING & OSTLING, NO COR MAT, 1 WIT;  
11/18/1947, R.OSTLING, CLEAR VIEW SUB 3-30, COR MAT, 3 WITS;  
10/20/1976, L.CAVANAGH, SURVEY-SEE DOSSIER, NO COR MAT, NO WITS;  
12/2/1976, L.CAVANAGH, (132) 329-288, COR MAT, NO WITS;  
6/1/1978, HENNING, (132) 347-288, NO COR MAT, 3 WITS;

B. Description of corner evidence found and/or method applied in restoring or reestablishing corner:

G-11: FOUND REMAINS OF CONCRETE MONUMENT, RESET CORNER FROM CAVANAGH SURVEY DATED 10/20/1976. ACCEPTED REESTABLISHED CORNER AS BEST EVIDENCE OF POSITION OF ORIGINAL CORNER. THIS CORNER ESTABLISHED IN ROSCOMMON COUNTY REMONUMENTATION PROGRAM. SEE DOSSIER FOR DETAILED REPORT.

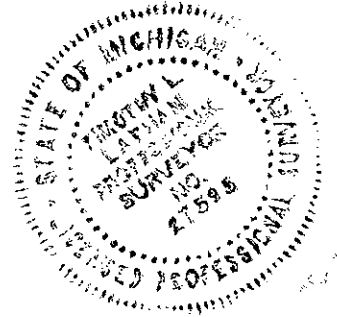

C. Description of monument for corner and accessories established to perpetuate locating the position of the corner:

G-11: SET 2" X 21" CAST IRON MONUMENT WITH BRASS ROSCOMMON COUNTY PLATE  
AZ 133° 16.42' NW CORNER FOUNDATION OF HOUSE  
AZ 80° 15.91' SET SPIKE & TAG IN NORTH FACE 12" MAPLE  
AZ 325° 58.99' SW CORNER FOUNDATION OF TWO STORY PART OF HOUSE  
AZ 04° 14.82' SPIKE IN WEST FACE 8" BIRCH  
AZ 350° 24.65' SET CARSONITE SURVEY MARKER POST AT END OF SPLIT RAIL FENCE

Signed by [Signature] Date 12/20/93

Surveyor's Michigan License No. 27595

Date 11/30/93

Peer Group Approved

LIBER 3 PAGE 38