

9073

ROSCOMMON COUNTY REMONUMENTATION

Dec 21 10 51 AM '93

LAND CORNER RECORDATION CERTIFICATE
Filing Requirement of Act 74, Mich. P.A. 1970

For corners in _____

RECORDED

ROSCOMMON (County)	Located In:	Corner Code #
1. Public Land Survey	T <u>23N</u> R <u>4W</u>	<u>G-12</u>
	T _____ R _____	_____
	T _____ R _____	_____
	T _____ R _____	_____
2. Property Controlling in Section	S _____ T _____ R _____	_____
	S _____ T _____ R _____	_____
3. Miscellaneous Property in Sec.	S _____ T _____ R _____	_____
	S _____ T _____ R _____	_____

ROSCOMMON COUNTY
PEER GROUP APPROVAL
DATE 11/30/93

TO BE FILED IN LIBER 3 OF LAND CORNERS
Register of Deeds Stamp & File Number

4. Lot No. _____, Recorded Plat _____
5. Private Claims _____

	A	B	C	D	E	F	G	H	I	J	K	L	M
2	6	5	4	3	2	1							
3													
4	7	8	9	10	11	12							
5													
6	18	17	16	15	14	13							
7													
8	19	20	21	22	23	24							
9													
10	30	29	28	27	26	25							
11													
12	31	32	33	34	35	36							
13													

I, TIMOTHY L. LAPHAM, in a field survey on November, 19 93, do hereby certify that under requirements of P.A. 74, Michigan P.A. of 1970, the corner points mentioned in lines 1 and 2 above were in conformance with regulations and rules therefore as required in the current manual of survey instructions of the United States Department of the Interior, Bureau of Land Management or by a decree of a Court of Law and/or that the corner points mentioned in lines 3, 4 and 5 above were in conformance with the rules of the Michigan Board of Land Surveyors or by a Decree of a Court of Law; established, re-established, monumented, re-monumented, recovered, found as expressed below:

NOTE: Not more than 4 corners, all in the same town and range, may be recorded on this certificate.

A. Description of original monument and accessories and/or subsequent restoration:


G-12: 1852, J.CURTIS, POST, TAMARACK 14" S50E 38L, CEDAR 8" N15W 16L;
UNKNOWN, UNKNOWN, LCRC 2-428, NO INFO;
4/27/1944, UNKNOWN, LANTZ SUBDIVISION, PLATS 2-58, COR MAT, NO WIT;
2/1949, R.OSTLING, LANTZ SUBD, PLATS 2-58, NO NEW INFO;
10/10/1975, L.CAVANAGH, SURVEY 311-39, COR MAT, NO WITS;
5/20/1991, L.CAVANAGH, SURVEY NOT REC, NO COR MAT, 4 WITS

B. Description of corner evidence found and/or method applied in restoring or reestablishing corner:

G-12: FOUND 3" BRASS CAP (DNR PUBLIC FISHING SITE) DATED 1955
CHAIN LINK FENCE POST S70E 1.03'
FACE OF POWER POLE S20E 52.4'
BUILDING CORNER N29E 48.5'
STOP SIGN POST N77W 65.55'
ACCEPTED FOUND CORNER AS BEST EVIDENCE OF POSITION OF ORIGINAL CORNER.
THIS CORNER ESTABLISHED IN ROSCOMMON COUNTY REMONUMENTATION PROGRAM.
SEE DOSSIER FOR DETAILED REPORT.

C. Description of monument for corner and accessories established to perpetuate locating the position of the corner:

G-12: 3" BRASS CAP MONUMENT (DNR PUBLIC FISHING SITE) DATED 1955
AZ 110°1.1' FACE OF CHAIN LINK FENCE POST
AZ 148° 52.97' SPIKE & TAG IN NE FACE UTILITY POLE
AZ 24° 48.35' SW BUILDING CORNER (HOLIDAY ON THE LAKE MOTEL-S WING)
AZ 278° 61.81' TO NEAR EDGE OF STOP SIGN POST
AZ 86° 309' APPROX. SHORELINE HOUGHTON LAKE
AZ 60° 1.08' SET CARSONITE SURVEY MARKER POST

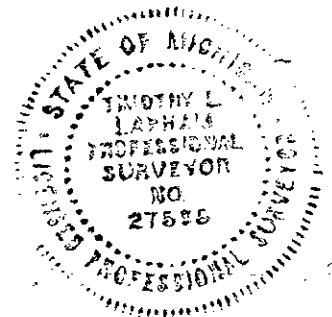

Signed by [Signature] Date 12/20/93

Surveyor's Michigan License No. 27595

Date 11/30/93 Peer Group Approved