

ROSCOMMON COUNTY REMONUMENTATION

9072
FEB 1 1994

LAND CORNER RECORDATION CERTIFICATE
Filing Requirement of Act 74, Mich. P.A. 1970

DEC 21 10 51 AM '93

For corners in ROSCOMMON

ROSCOMMON (County)	Located In:	Corner Code #
1. Public Land Survey	T <u>23N</u> R <u>4W</u>	<u>G-13</u>
	T _____ R _____	_____
	T _____ R _____	_____
	T _____ R _____	_____
2. Property Controlling in Section	S _____ T _____ R _____	_____
	S _____ T _____ R _____	_____
3. Miscellaneous Property in Sec.	S _____ T _____ R _____	_____
	S _____ T _____ R _____	_____

Robert L. Lapham
REGISTERED SURVEYOR
**ROSCOMMON COUNTY
PEER GROUP APPROVAL
DATE 11/30/93**

TO BE FILED IN LIBER 3 OF LAND CORNERS
Register of Deeds Stamp & File Number

4. Lot No. _____, Recorded Plat _____
5. Private Claims _____

	A	B	C	D	E	F	G	H	I	J	K	L	M
2	6	5	4	3	2	1							
3													
4	7	8	9	10	11	12							
5													
6	18	17	16	15	14	13							
7													
8	19	20	21	22	23	24							
9													
10	30	29	28	27	26	25							
11													
12	31	32	33	34	35	36							
13													

I, **TIMOTHY L. LAPHAM**, in a field survey on November, 19 93, do hereby certify that under requirements of P.A. 74, Michigan P.A. of 1970, the corner points mentioned in lines 1 and 2 above were in conformance with regulations and rules therefore as required in the current manual of survey instructions of the United States Department of the Interior, Bureau of Land Management or by a decree of a Court of Law and/or that the corner points mentioned in lines 3, 4 and 5 above were in conformance with the rules of the Michigan Board of Land Surveyors or by a Decree of a Court of Law; established, re-established, monumented, re-monumented, recovered, found as expressed below:

NOTE: Not more than 4 corners, all in the same town and range, may be recorded on this certificate.

A. Description of original monument and accessories and/or subsequent restoration:


G-13: 1838, J. BRINK, POST, BEECH 8" N28E 19L, BEECH 12" N38.5W 14L; LCRC 2-255, COR MAT, NO WITS; 10/21/1940 BEBEE SUBD, PLAT 2-31, NO WIT; 3/21/46 OSTLING, NO WIT; 3/21/46 OSTLING, NO WIT; 12/69 HENNING, NO WIT; 12/69 HENNING, NO WIT; 7/10/75 CAVANAGH (132)309-522 COR MAT, 2 WITS; 2/21/77 CAVANAGH (132)329-292, COR MAT, 2 WITS; 4/12/77 CAVANAGH (132)331-452 NO NEW INFO; 4/12/77 CAVANAGH (132)331-450 NO NEW INFO; 6/78 CAVANAGH LCRC 1-137 COR MAT 3 WITS; 6/4/78 CAVANAGH (132)348-593 COR MAT 4 WITS; 7/25/78 CAVANAGH COR MAT 4 WITS; 11/1/78 CAVANAGH (132)357-185 COR MAT 4 WITS; 9/14/79 CAVANAGH LCRC 1-210, COR MAT 4 WITS; 11/14/79 CAVANAGH, NO NEW INFO; 7/16/81 CAVANAGH (132)393-252 COR MAT 4 WITS; 4/4/83 CAVANAGH (132)429-446 COR MAT 4 WITS; 12/28/88 CAVANAGH COR MAT 4 WIT; 6/18/90 CAVANAGH (132)589-447 COR MAT 3 WIT; 5/20/91 CAVANAGH COR MAT 4 WT

B. Description of corner evidence found and/or method applied in restoring or reestablishing corner:

G-13: FOUND 1/2" PIPE INSIDE 1 1/4" PIPE (1'+/- DEEP) INSIDE PAVEMENT BOX AT INTERSECTION M55 & OLD 27.
SPIKE IN POLE S44W 72.15'
SPIKE IN POLE N42E 69.4'
SPIKE IN POLE S50E 70.45'
ACCEPTED FOUND CORNER AS BEST EVIDENCE OF POSITION OF ORIGINAL CORNER. THIS CORNER ESTABLISHED IN ROSCOMMON COUNTY REMONUMENTATION PROGRAM. SEE DOSSIER FOR DETAILED REPORT.

C. Description of monument for corner and accessories established to perpetuate locating the position of the corner:

G-13: SET 2" X 21" CAST IRON MONUMENT WITH BRASS ROSCOMMON COUNTY PLATE IN MONUMENT BOX.
AZ. 42° 69.70' FOUND SPIKE IN TRAFFIC LIGHT POLE NW FACE
AZ. 302° 76.49' SET SPIKE AND TAG IN SW FACE UTILITY POLE
AZ 224° 72.20' FOUND SPIKE NW FACE UTILITY POLE
AZ 116° 70.46' SET SPIKE AND TAG IN NE FACE UTILITY POLE

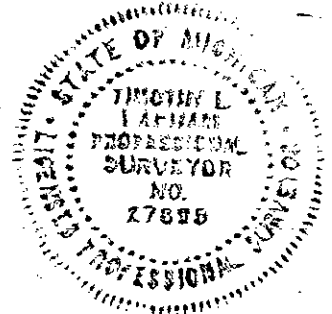

Signed by *Timothy L. Lapham* Date 12/20/93

Surveyor's Michigan License No. 27595

Date 11/30/93

Peer Group Approved

LIBER

3 PAGE 36