

ROSCOMMON COUNTY  
PEER GROUP APPROVAL  
DATE 12-28-94

ROSCOMMON COUNTY REMONUMENTATION  
LAND CORNER RECORDATION CERTIFICATE  
Filing Requirement of Act 74, Mich. P.A. 1970

JAN 24 1995  
COMMISSION

For corners in  
ROSCOMMON

(County)

Located In:

Corner Code #

- 1. Public Land Survey T 23N R 4W J-3
- T \_\_\_\_\_ R \_\_\_\_\_
- T \_\_\_\_\_ R \_\_\_\_\_
- T \_\_\_\_\_ R \_\_\_\_\_
- 2. Property Controlling S \_\_\_\_\_ T \_\_\_\_\_ R \_\_\_\_\_
- in Section S \_\_\_\_\_ T \_\_\_\_\_ R \_\_\_\_\_
- 3. Miscellaneous S \_\_\_\_\_ T \_\_\_\_\_ R \_\_\_\_\_
- Property in Sec. S \_\_\_\_\_ T \_\_\_\_\_ R \_\_\_\_\_

~~SURVEY &~~  
~~REMONUMENTATION~~  
APR 05 1996  
COMMISSION

STATE OF MICHIGAN  
ROSCOMMON COUNTY  
RECORDED

28 DEC 94 1:07 P.M.

ROBERT W. SMITH  
REGISTER OF DEEDS

TO BE FILED IN LIBER 3 OF LAND CORNER  
Register of Deeds Stamp & File Number

- 4. Lot No. \_\_\_\_\_, Recorded Plat \_\_\_\_\_
- 5. Private Claims \_\_\_\_\_

	A	B	C	D	E	F	G	H	I	J	K	L	M
2	6	5	4	3	2	1							
3													
4	7	8	9	10	11	12							
5													
6	18	17	16	15	14	13							
7													
8	19	20	21	22	23	24							
9													
10	30	29	28	27	26	25							
11													
12	31	32	33	34	35	36							
13													


Timothy L. Lapham, in a field survey on December, 19 94, do hereby certify that under requirements of P.A. 74, Michigan P.A. of 1970, the corner points mentioned in lines 1 and 2 above were in conformance with regulations and rules therefore as required in the current manual of survey instructions of the United States Department of the Interior, Bureau of Land Management or by a decree of a Court of Law and/or that the corner points mentioned in lines 3, 4 and 5 above were in conformance with the rules of the Michigan Board of Land Surveyors or by a Decree of a Court of Law; established, re-established, monumented, re-monumented, recovered, found as expressed below:

NOTE: Not more than 4 corners, all in the same town and range, may be recorded on this certificate.

A. Description of original monument and accessories and/or subsequent restoration:  
J-3: 1852 CURTIS, SET POST, 7" SPRUCE N70E 42LK., 8" SPRUCE S60W 45LK.,  
4/15/1903 KIRBY, CO. SURVEY RECORD, SET POST, TAMARACK 10" N51E 45 LK.,  
W. BIRCH 10" S51W 36-1/2LK,

B. Description of corner evidence found and/or method applied in restoring or reestablishing corner:  
J-3: NO EVIDENCE OF CORNER POSITION FOUND, SET BY SINGLE PROPORTIONATE DISTANCE BETWEEN I-3 AND  
K-3, ACCEPTED ESTABLISHED POSITION AS BEST EVIDENCE OF ORIGINAL CORNER POSITION.  
CORNER APPROVED AT PEER REVIEW MEETING 12-28, 1994. SEE DOSSIER FOR ADDITIONAL INFORMATION.

C. Description of monument for corner and accessories established to perpetuate locating the position of the corner:  
J-3: SET 60"x3/4" BLACK PIPE 54" INTO GROUND WITH PLASTIC CAP #27595  
N44E 32.69 SET NAIL AND TAG IN NW FACE OF 5" TAMARACK  
S38E 52.54 SET NAIL AND TAG IN NE FACE OF 16" LEANING CEDAR  
S60W 41.39 SET NAIL AND TAG IN SE FACE OF 20" TAMARACK  
SOUTH 14.73 FACE OF CARSONITE POST

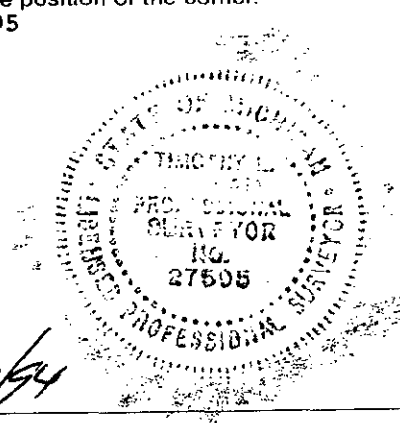

Signed by [Signature] Date 12/27/94  
Surveyor's Michigan License No. 27595

1 - 2 D... 277