

JAN 24 1995

COMMISSION

ROSCOMMON COUNTY
PEER GROUP APPROVAL
DATE 12-28-94

ROSCOMMON COUNTY REMONUMENTATION
LAND CORNER RECORDATION CERTIFICATE
Filing Requirement of Act 74, Mich. P.A. 1970

For corners in
ROSCOMMON
(County)

Located In:

Corner Code #

TO BE FILED IN LIBER 3 OF LAND CORNER

STATE OF MICHIGAN
ROSCOMMON COUNTY
RECORDED

28 DEC 94 1:05 P.M.

ROBERT W. SMITH
REGISTER OF DEEDS

Register of Deeds Stamp & File Number

- 1. Public Land Survey T 23N R 4W K-3
T _____ R _____
T _____ R _____
T _____ R _____
- 2. Property Controlling S _____ T _____ R _____
in Section S _____ T _____ R _____
- 3. Miscellaneous S _____ T _____ R _____
Property in Sec. S _____ T _____ R _____
- 4. Lot No. _____, Recorded Plat _____
- 5. Private Claims _____

COMMISSION

A	B	C	D	E	F	G	H	I	J	K	L	M
2	6	5	4	3	2	1						
3												
4	7	8	9	10	11	12						
5												
6	18	17	16	15	14	13						
7												
8	19	20	21	22	23	24						
9												
10	30	29	28	27	26	25						
11												
12	31	32	33	34	35	36						
13												

I, Timothy L. Lapham, in a field survey on December, 1994


do hereby certify that under requirements of P.A. 74, Michigan P.A. of 1970, the corner points mentioned in lines 1 and 2 above were in conformance with regulations and rules therefore as required in the current manual of survey instructions of the United States Department of the Interior, Bureau of Land Management or by a decree of a Court of Law and/or that the corner points mentioned in lines 3, 4 and 5 above were in conformance with the rules of the Michigan Board of Land Surveyors or by a Decree of a Court of Law; established, re-established, monumented, re-monumented, recovered, found as expressed below:

NOTE: Not more than 4 corners, all in the same town and range, may be recorded on this certificate.

A. Description of original monument and accessories and/or subsequent restoration:
K-3: ~~1852~~ CURTIS, SET POST, CEDAR 8" N40W 12LK., TAMARACK 12" S55E 35LK.,
NO SURVEYS OR LCRCs OR RECORD

B. Description of corner evidence found and/or method applied in restoring or reestablishing corner:
K-3: NO EVIDENCE OF CORNER FOUND, SET BY DOUBLE PROPORTIONATE MEASURE BETWEEN K-1 AND K-4 AND BETWEEN I-3 AND M-3, ACCEPTED ESTABLISHED POSITION AS BEST EVIDENCE OF ORIGINAL CORNER POSITION.
CORNER APPROVED AT PEER REVIEW MEETING 12-28, 1994. SEE DOSSIER FOR ADDITIONAL INFORMATION.

C. Description of monument for corner and accessories established to perpetuate locating the position of the corner:
K-3: SET 60"x3/4" BLACK PIPE 54" INTO GROUND WITH PLASTIC PS CAP #27595
N52E 7.21 SET NAIL AND TAG IN NW FACE OF 8" CEDAR
S52E 13.95 SET NAIL AND TAG IN NE FACE OF 10" CEDAR
S22E 19.06 SET NAIL AND TAG IN NE FACE OF 7" CEDAR
N38W 17.28 SET NAIL AND TAG IN SW FACE OF 14" CEDAR
SOUTH 4.84 FACE OF CARSONITE POST

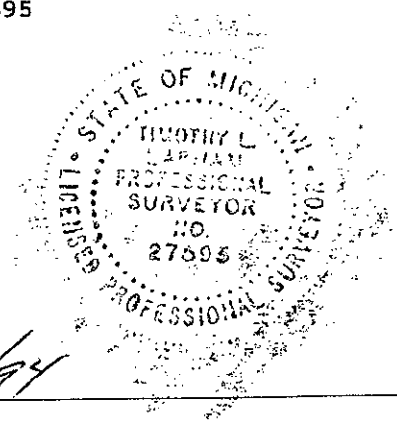

Signed by [Signature]

Date 12/27/94

Surveyor's Michigan License No. 27595